

01 FIRST FLOOR PLAN
SCALE: 1/8" = 1'-0"



OWNER:
Ramapo College of New Jersey
505 Ramapo Valley Road
Mahwah, New Jersey 07430-1630

CONSTRUCTION MANAGERS:
Cambridge Construction Management
335 East Main Street
Somerville, NJ 08876
908-253-9500

ARCHITECT:
Mitchell/Giurgola Architects, LLP
630 Ninth Avenue, Suite 711
New York, New York 10036
212 529 4000

MEP ENGINEER:
Joseph R. Loring & Associates, Inc.
619 River Drive Center 1
New York, NY 10001
212 563 7400



STRUCTURAL ENGINEER:
Yarael A. Seiniuk PC
228 East 45th Street 2nd Floor
New York, NY 10017
212 687 2233

LANDSCAPE ARCHITECT:
Dirtworks, PC
200 Park Avenue South
New York, NY 10003
212 529 2263

SITE CIVIL ENGINEER:
Langan Engineering
619 River Drive Center 1
Elmwood Park, NJ 07407-1338
201 794 6900

AV CONSULTANT:
Cerami & Associates
404 Fifth Avenue
New York, NY 10018
212 370 1776

Key Plan:

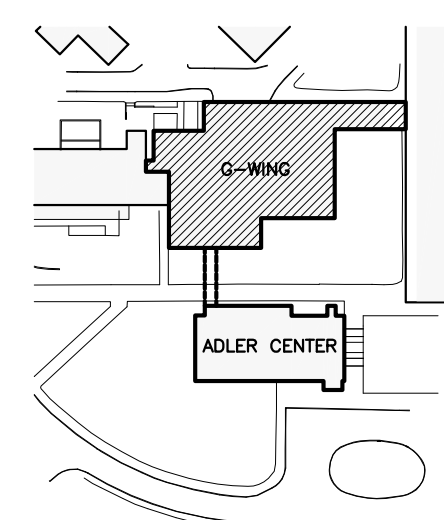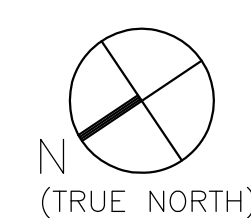

6/8/12	DCA FILING
7/19/12	ISSUED FOR BID
1/15/13	ISSUED FOR CONSTRUCTION
9/16/13	BULLETIN #10
1/09/14	CONFORMANCE SET
12/7/15	BULLETIN #35
8/12/16	AS-BUILT CONSTRUCTION DOCUMENTS
2/17/17	BULLETIN #35 (REVISED)
NR	DATE
ISSUE/REVISION	COMMENTS

ALL DIMENSIONS AND EXISTING CONDITIONS SHALL BE CHECKED AND VERIFIED BY THE CONTRACTOR BEFORE PROCEEDING WITH THE WORK.

Project:
G-WING RENOVATION & ADLER CENTER

Submission:
CONSTRUCTION DOCUMENTS

Drawing Title:
1ST FLOOR FINISH PLAN - G-WING

PROJECT NO: 102700
DATE: 6/8/12
CONJ. NO: 08-240C
SCALE: SCALE

A10.01G