



OWNER:
Ramapo College of New Jersey
505 Ramapo Valley Road
Mahwah, New Jersey 07430-1630

CONSTRUCTION MANAGERS:
Cambridge Construction Management
335 East Main Street
Somerville, NJ 08876
908-253-9500

ARCHITECT:
Mitchell/Giurgola Architects, LLP
630 Ninth Avenue, Suite 711
New York, New York 10036
212 663 4000

MEP ENGINEER:
Joseph R. Loring & Associates, Inc.
219 Pennsylvania Plaza
New York, NY 10001
212 563 7400

STRUCTURAL ENGINEER:
Yarael A. Selinuk PC
228 East 45th Street 2nd Floor
New York, NY 10017
212 687 2233

LANDSCAPE ARCHITECT:
Dirtworks, PC
200 Park Avenue South
New York, NY 10003
212 529 2263

SITE CIVIL ENGINEER:
Langan Engineering
619 River Drive Center 1
Elmwood Park, NJ 07407-1338
201 794 6900

AV CONSULTANT:
Cerami & Associates
404 Fifth Avenue
New York, NY 10018
212 370 1776

Key Plan:



6/8/12	DCA FILING	02/17/17	BULLETIN #35 (REVISED)
7/19/12	ISSUED FOR BID		
9/28/12	BID ADDENDUM #3		
1/15/13	ISSUED FOR CONSTRUCTION		
1/09/14	CONFORMANCE SET		
10/13/14	BULLETIN #25		
11/21/14	ASI #035		
12/7/15	BULLETIN #35		
8/12/16	AS-BUILT CONSTRUCTION DOCUMENTS		
NR	DATE	COMMENTS	DOCUMENTS
ISSUE/REVISION			
ALL DIMENSIONS AND EXISTING CONDITIONS SHALL BE CHECKED AND VERIFIED BY THE CONTRACTOR BEFORE PROCEEDING WITH THE WORK.			


Project:
G-WING RENOVATION & ADLER CENTER

Submission:
CONSTRUCTION DOCUMENTS


Drawing Title:
1ST FLOOR PARTIAL PLANS & INT. ELEVATIONS - G-WING

PROJECT NO: 102700
DATE: 6/8/12
RCH. NO: 08-240C
SCALE: AS NOTED


A9.03G

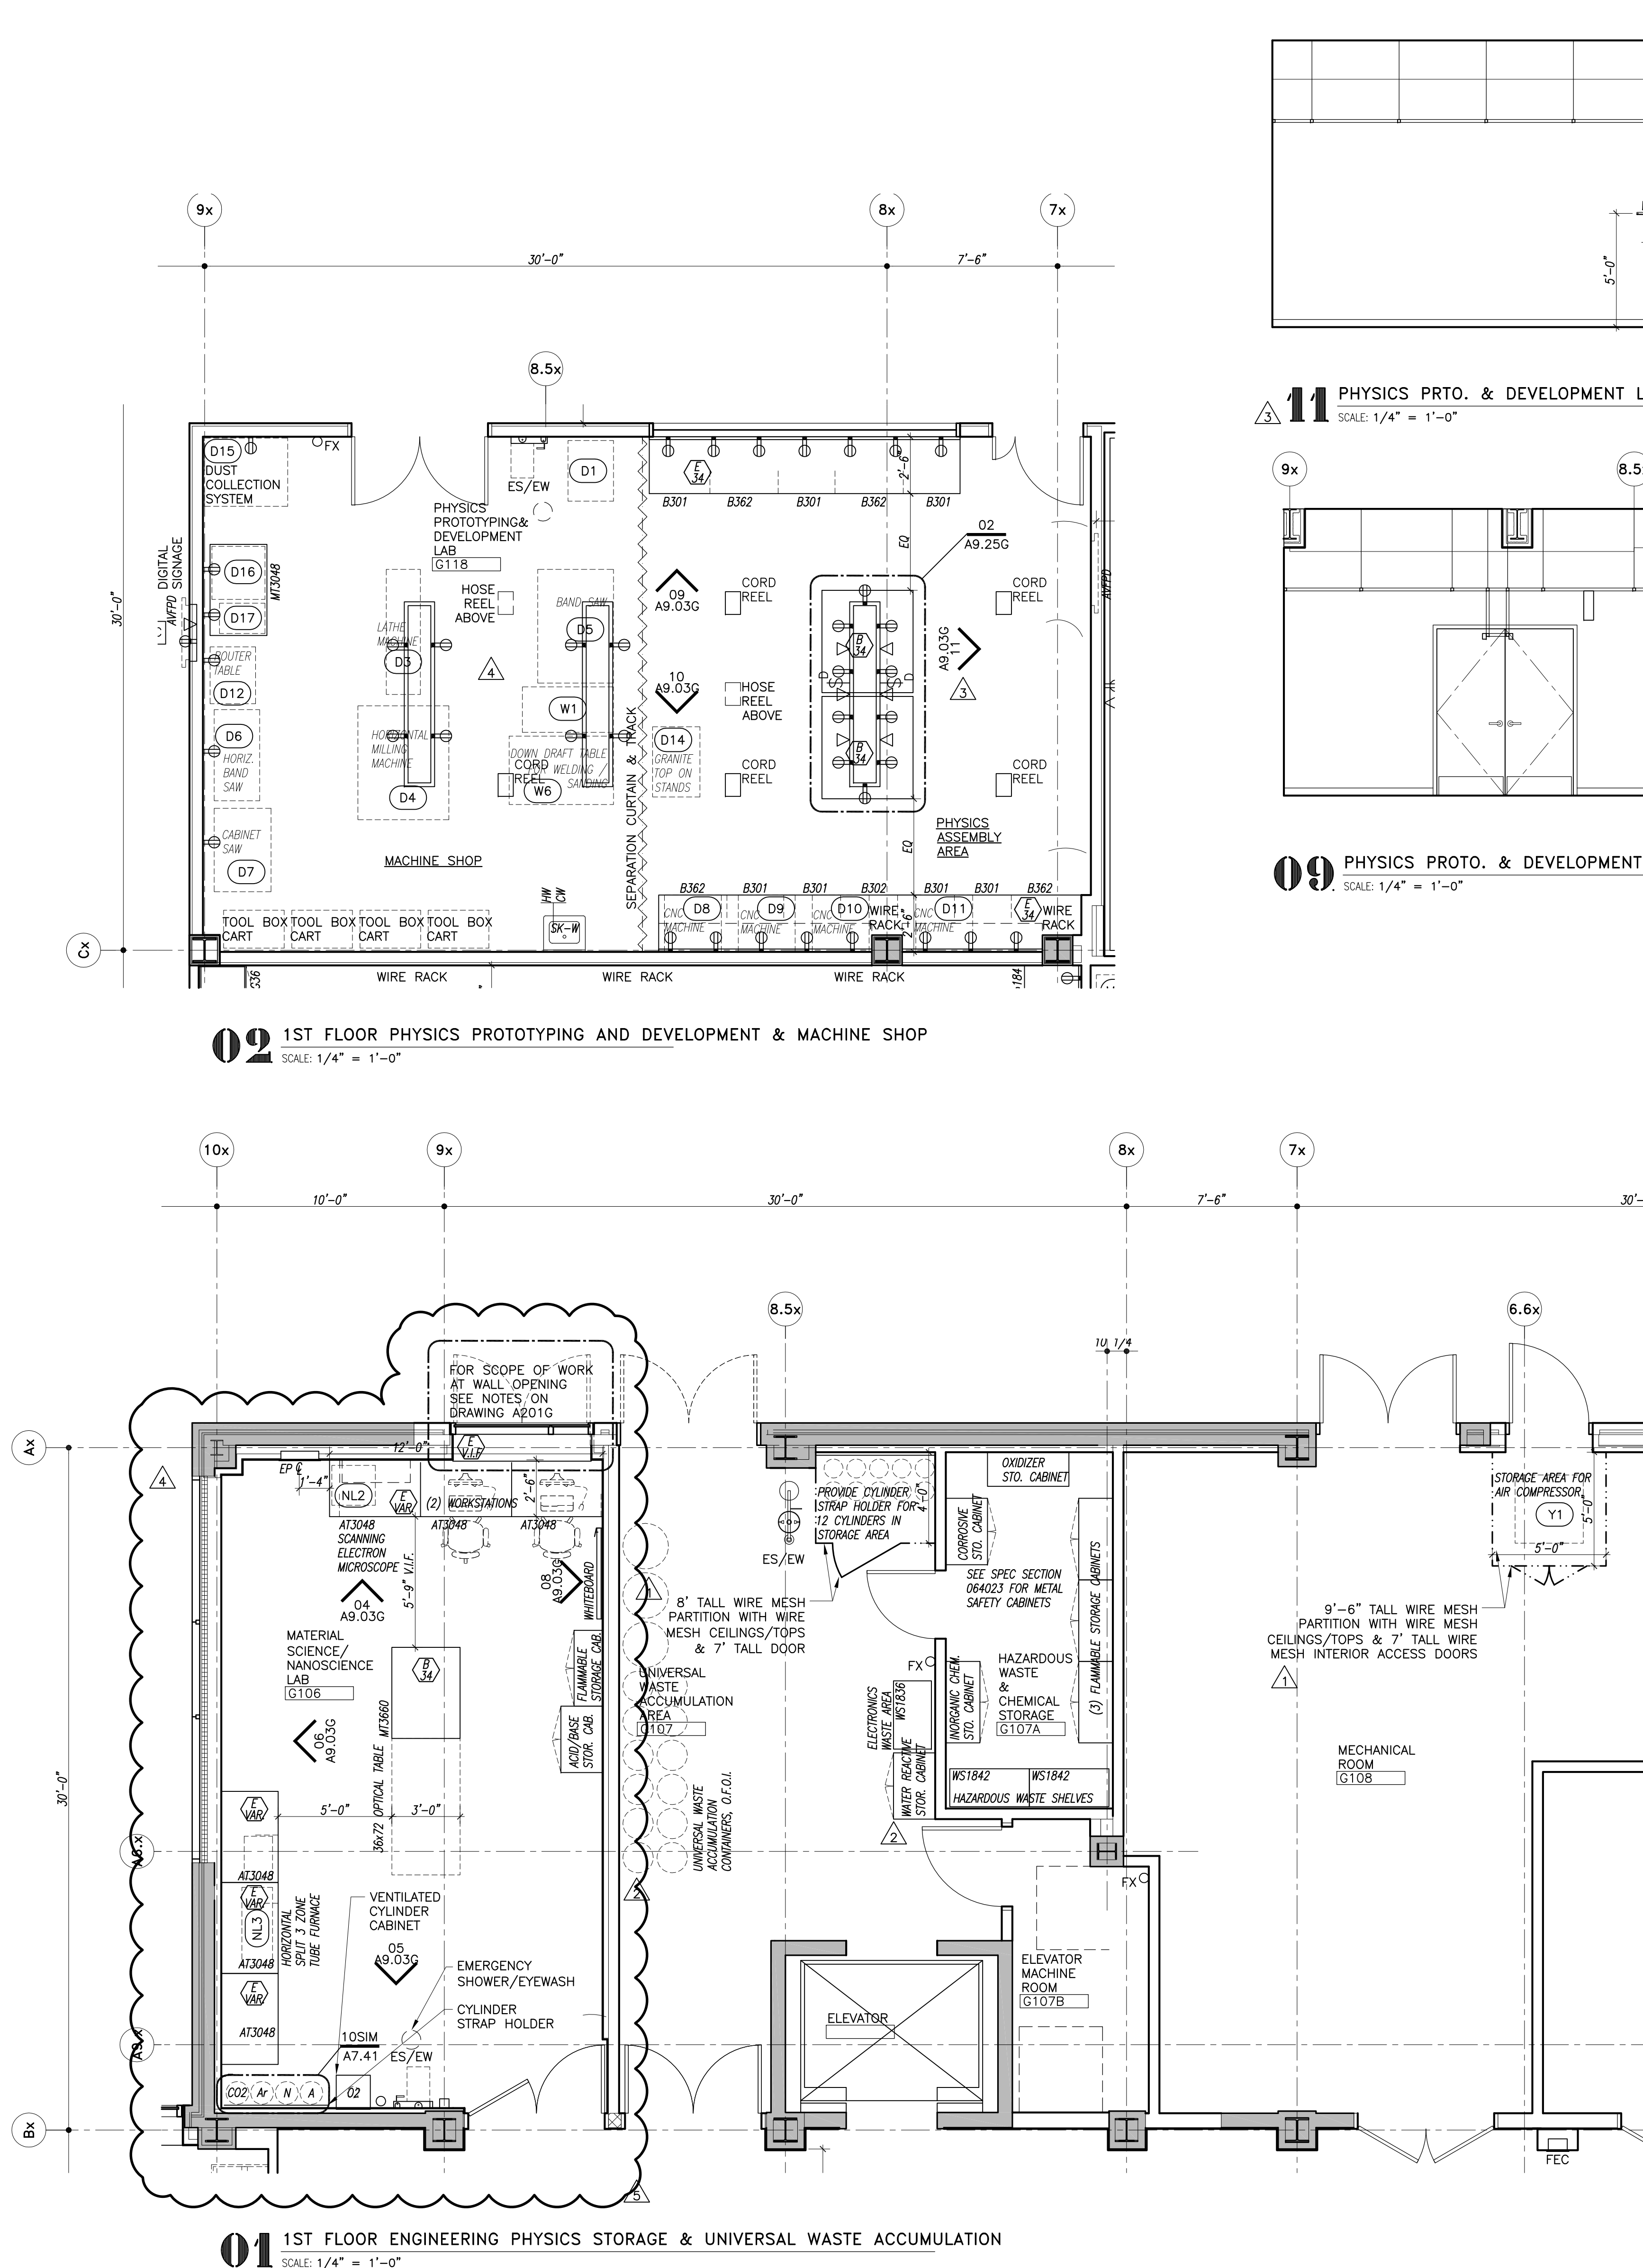


02 1ST FLOOR PHYSICS PROTOTYPING AND DEVELOPMENT & MACHINE SHOP
SCALE: 1/4" = 1'-0"

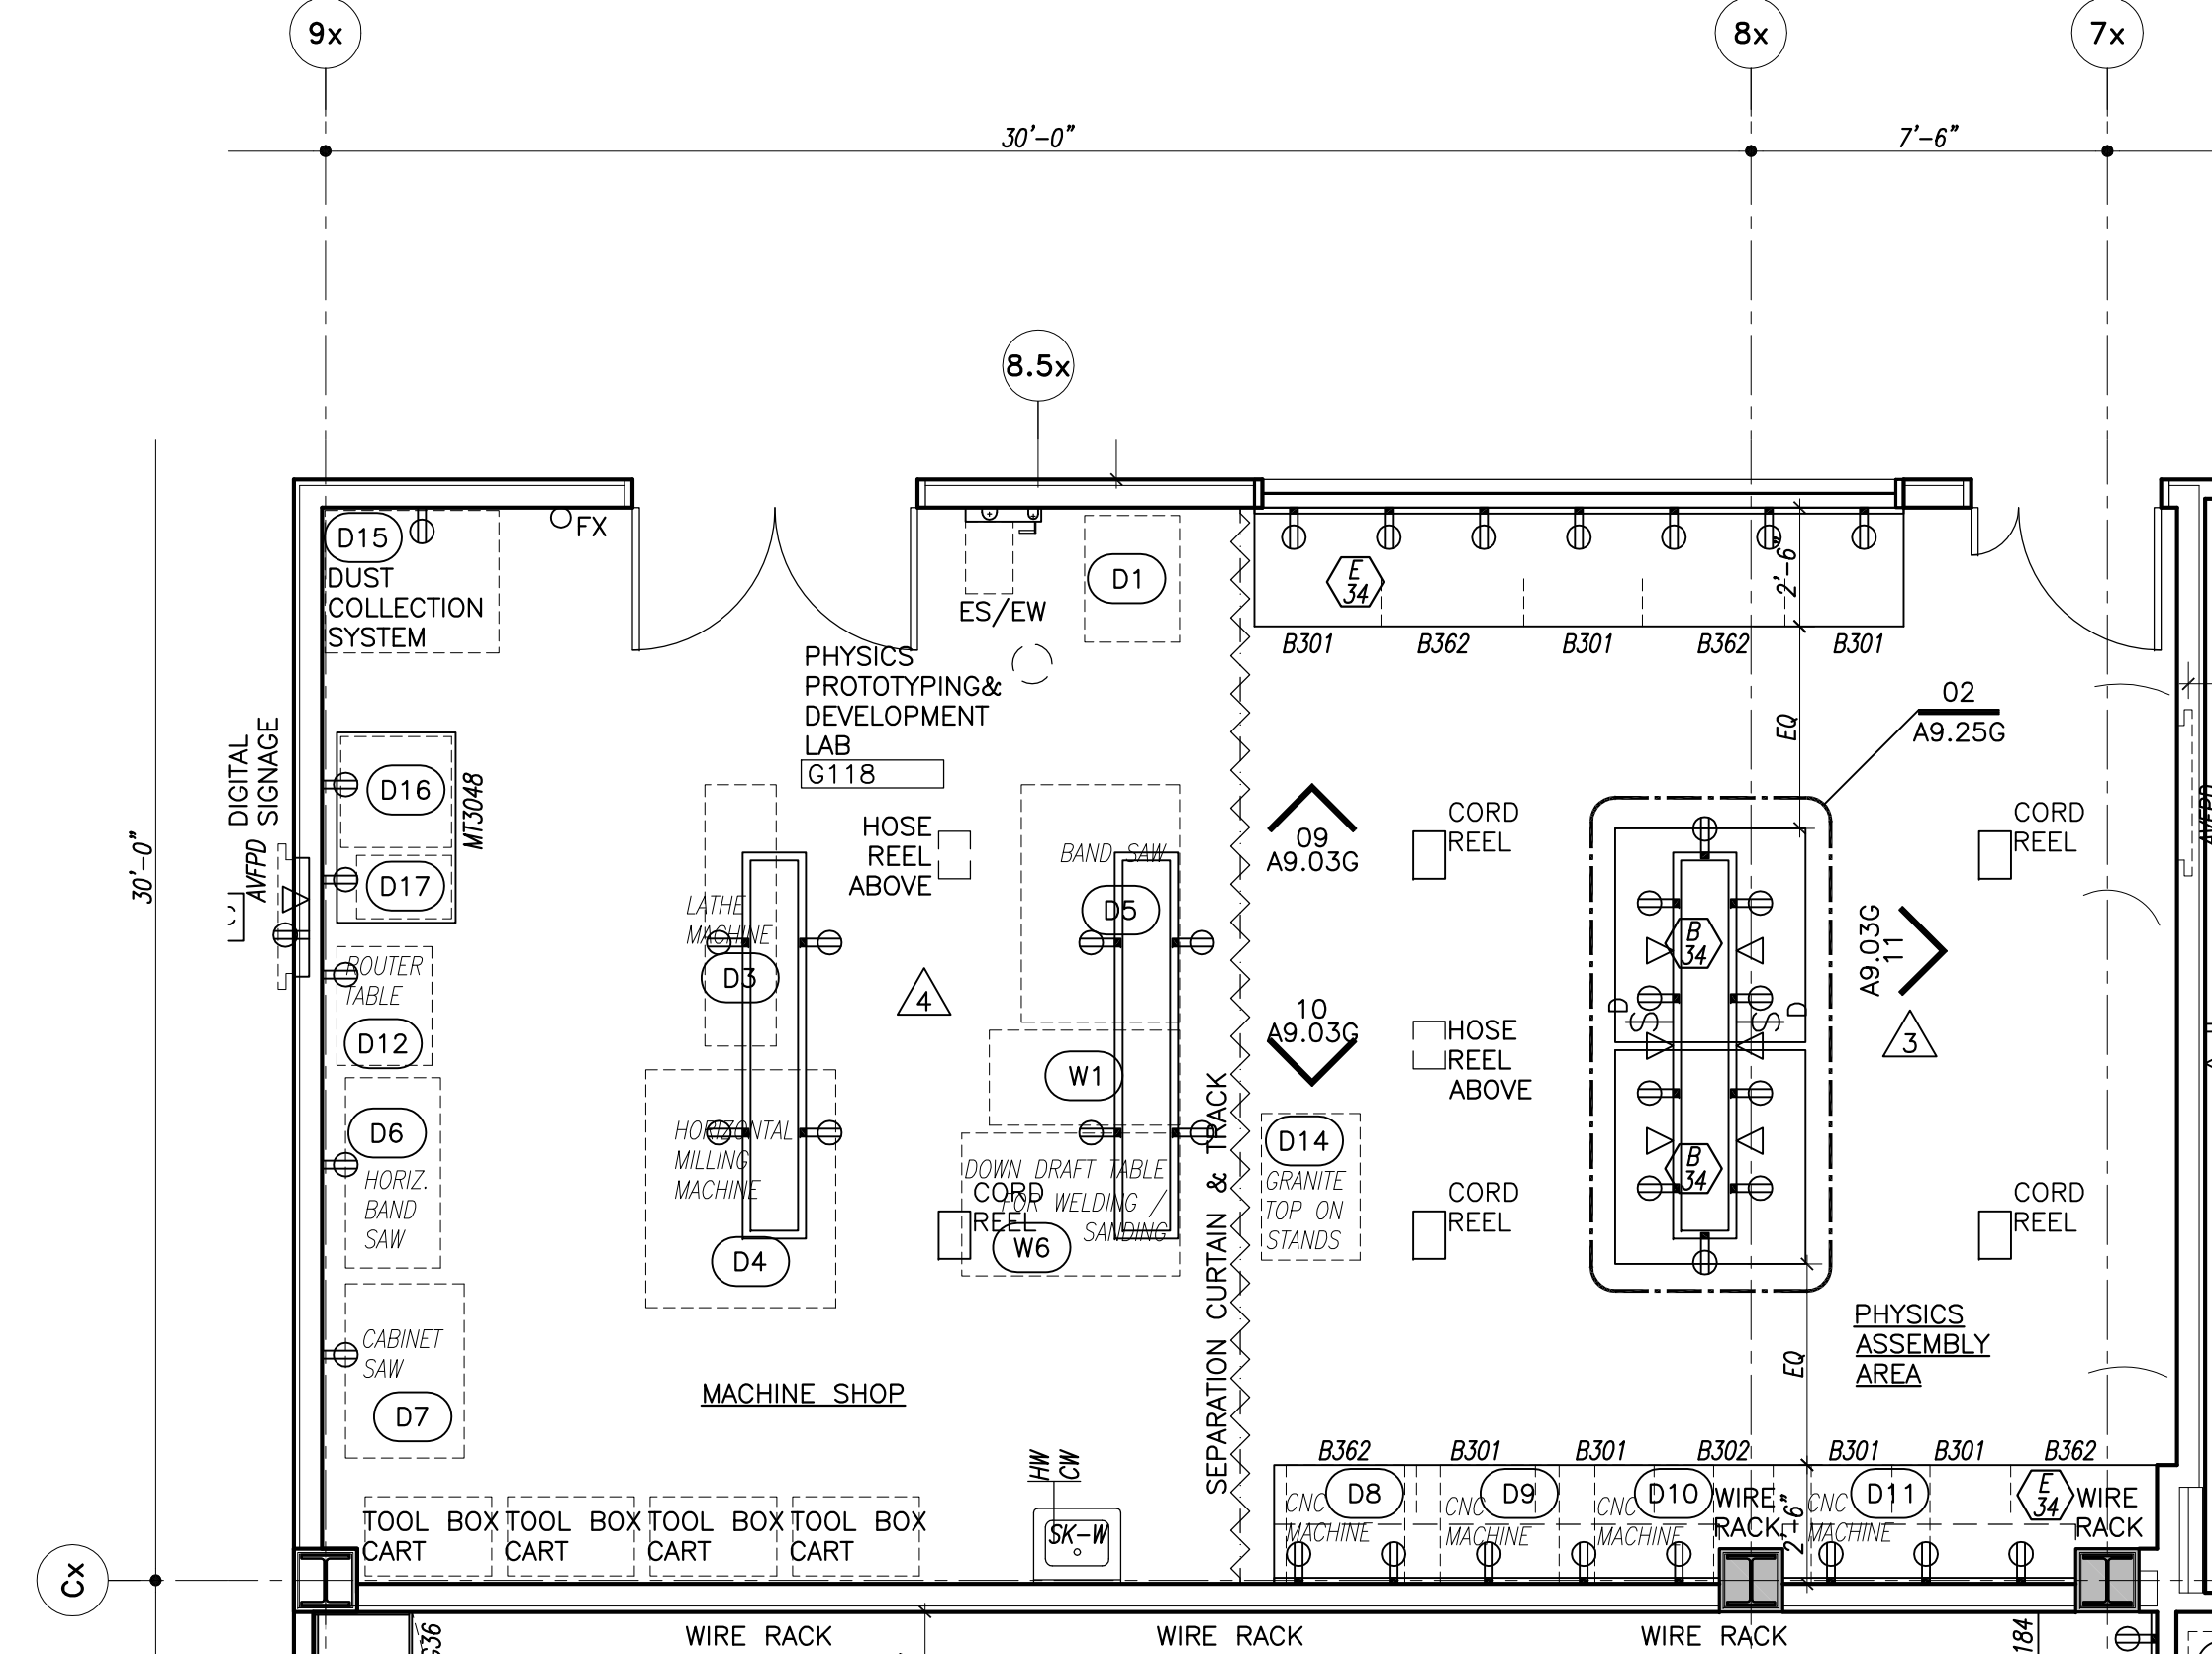


09 PHYSICS PROTO. & DEVELOPMENT LAB G118 EAST ELEVATION
SCALE: 1/4" = 1'-0"

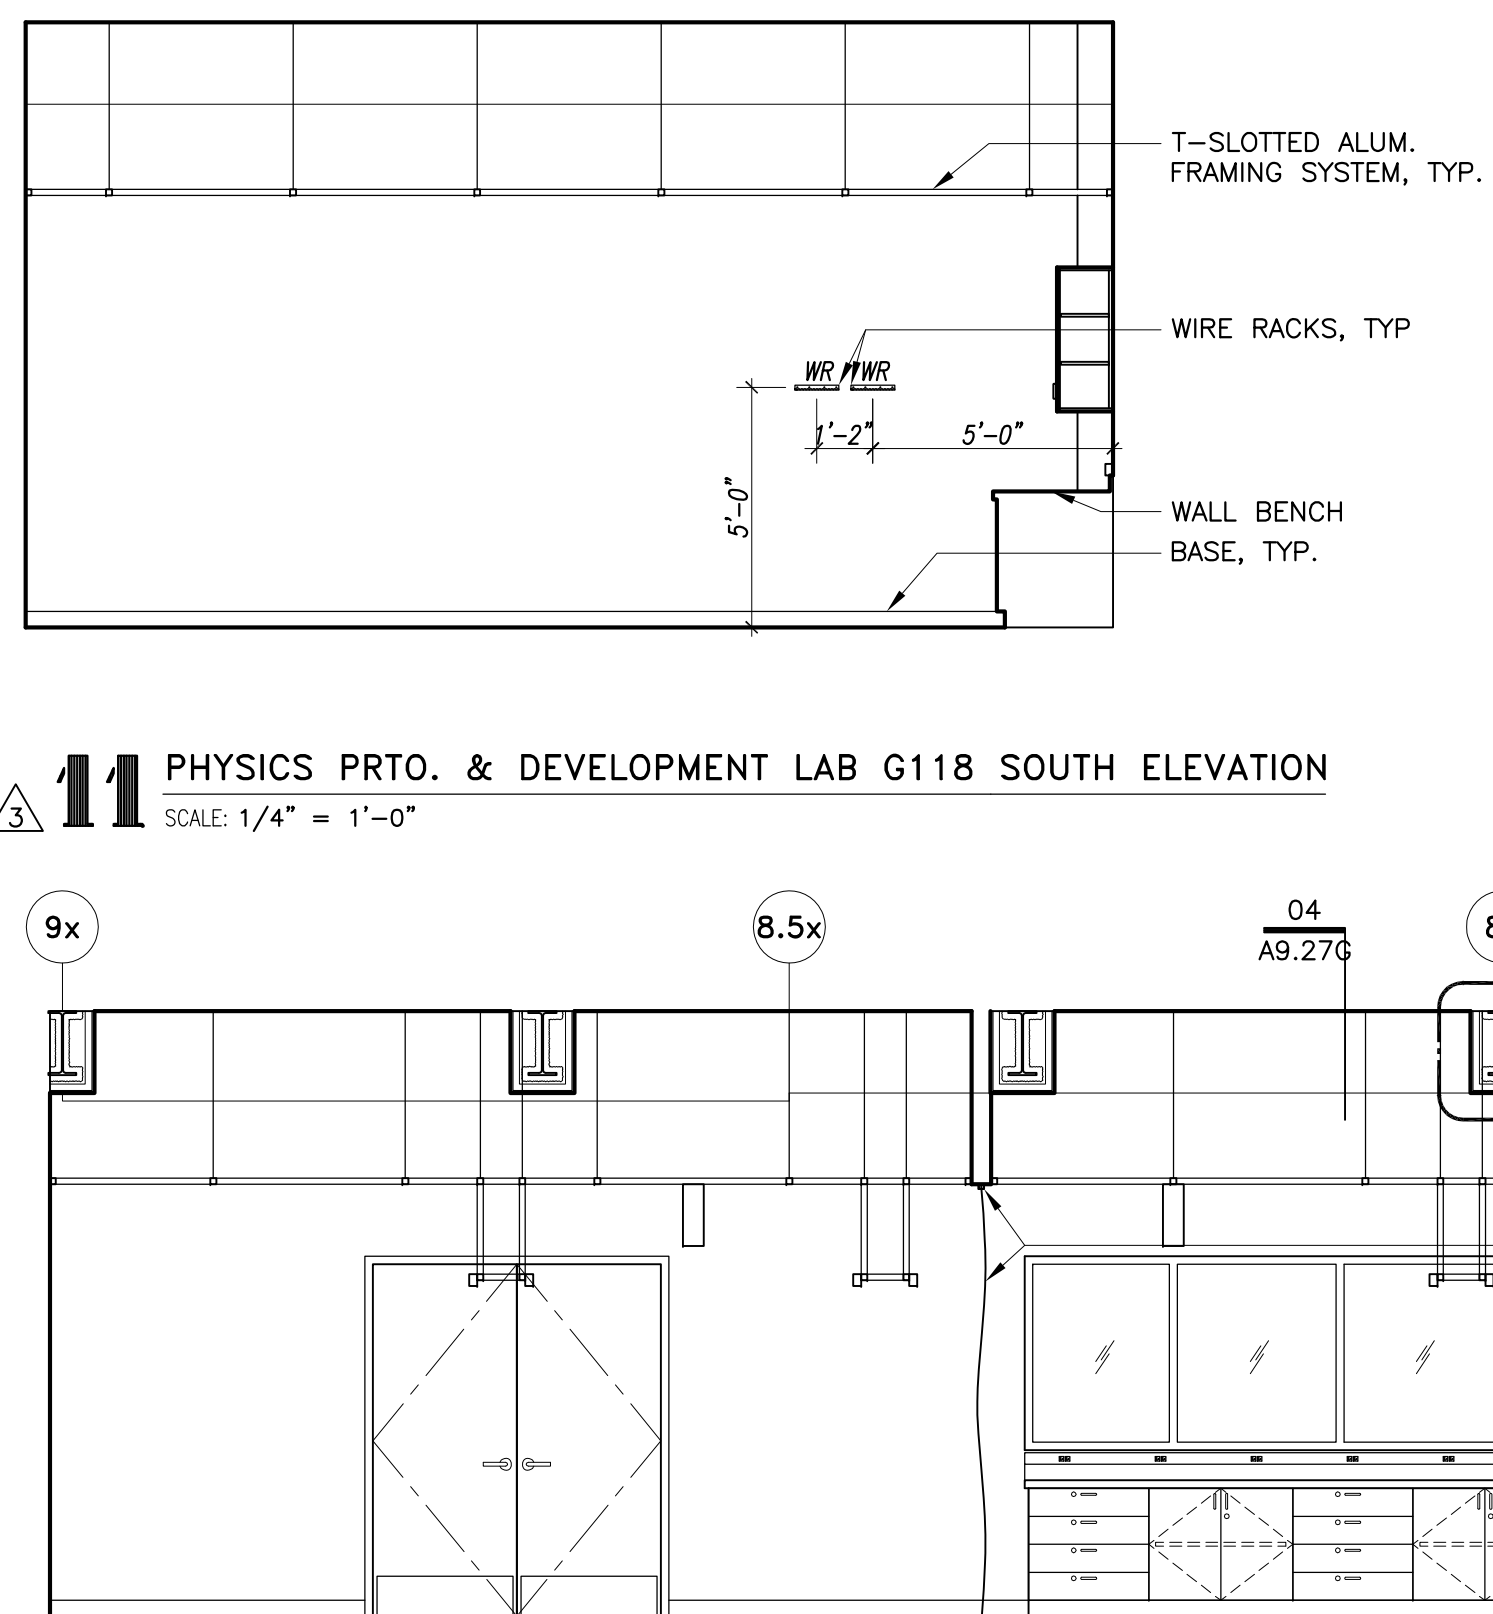


10 PHYSICS PROTO. & DEVELOPMENT LAB G118 WEST ELEVATION
SCALE: 1/4" = 1'-0"

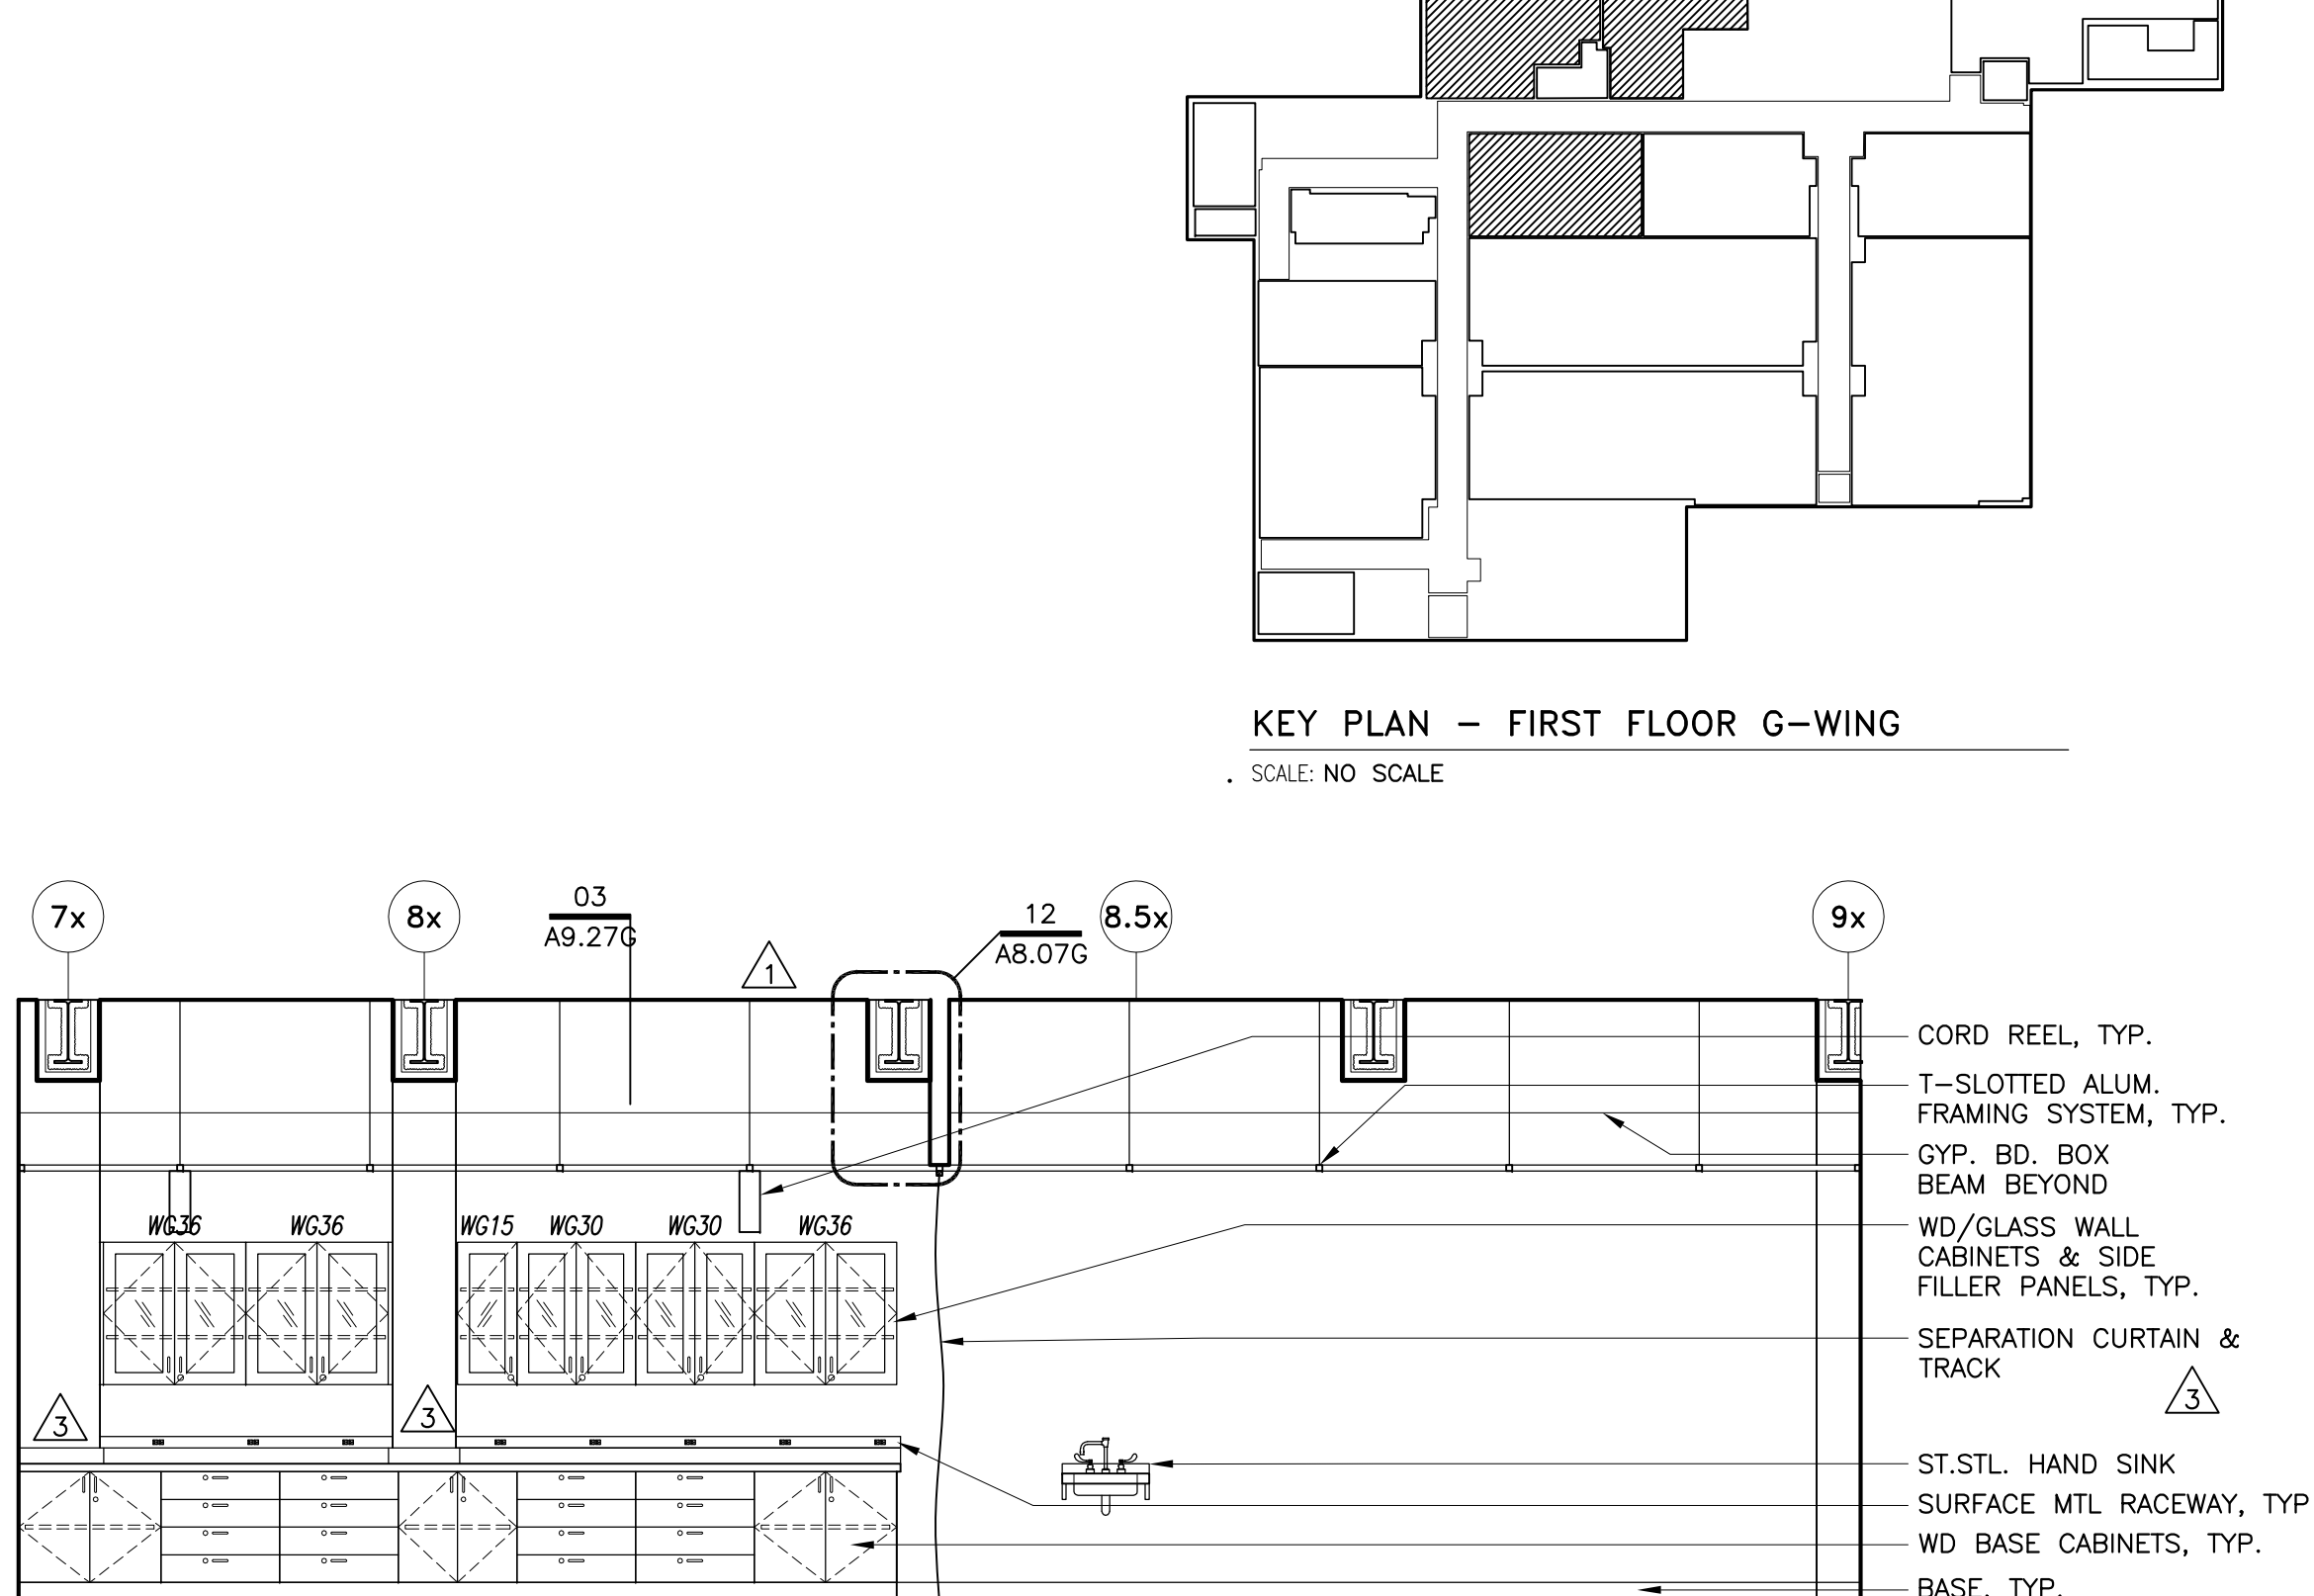


07 MATERIAL SCIENCE NANOSCIENCE LAB G106 NORTH ELEVATION
SCALE: 1/4" = 1'-0"

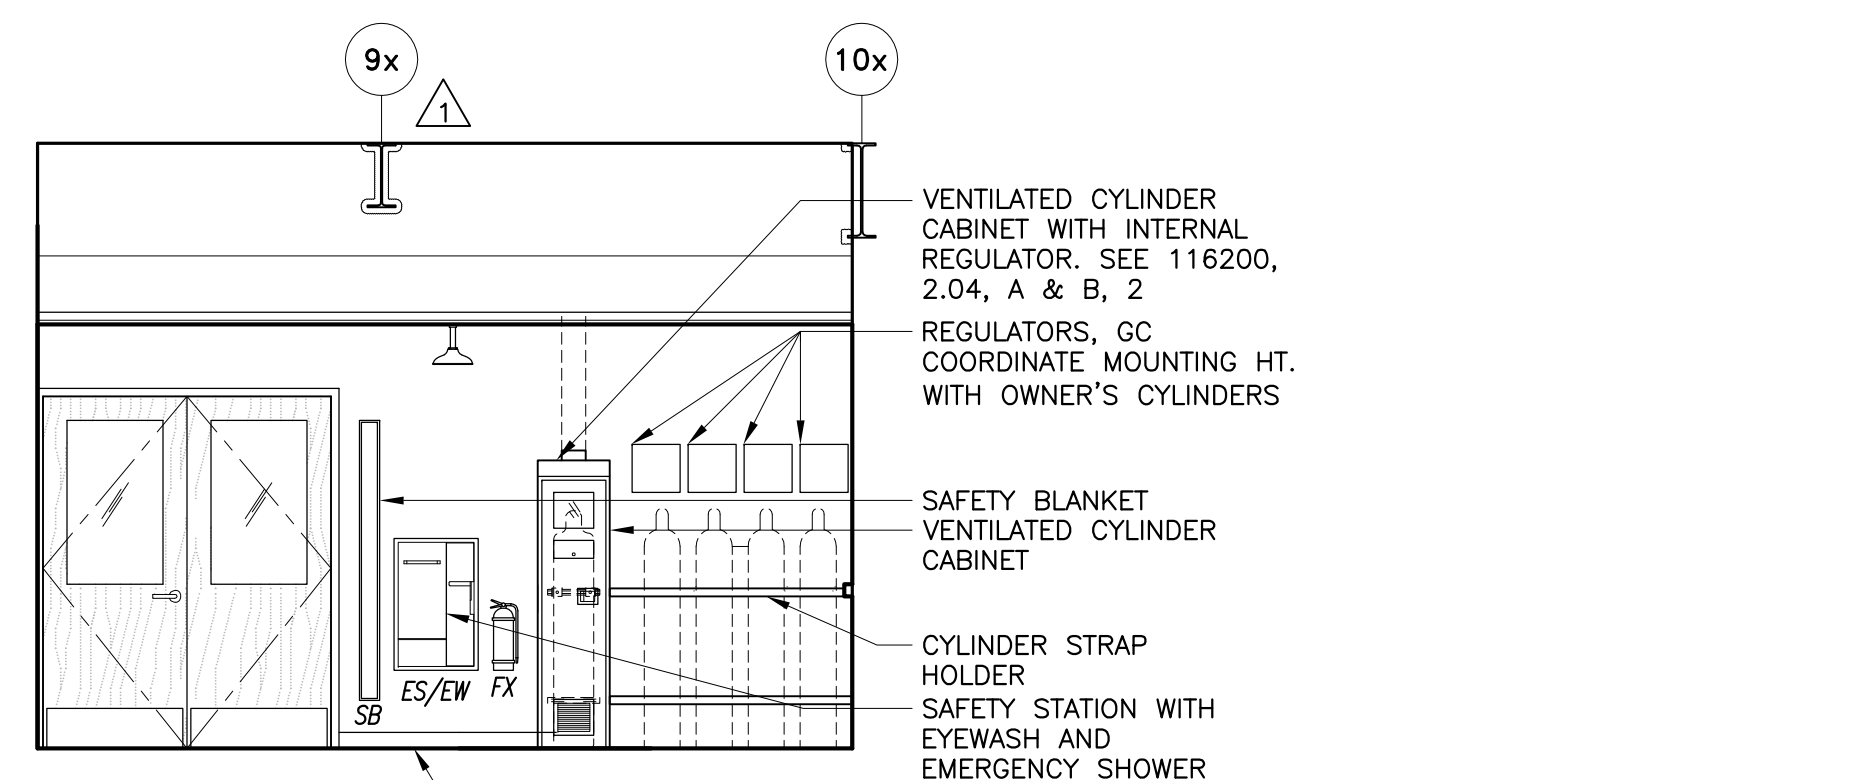


05 MATERIAL SCIENCE NANOSCIENCE LAB G106 WEST ELEVATION
SCALE: 1/4" = 1'-0"

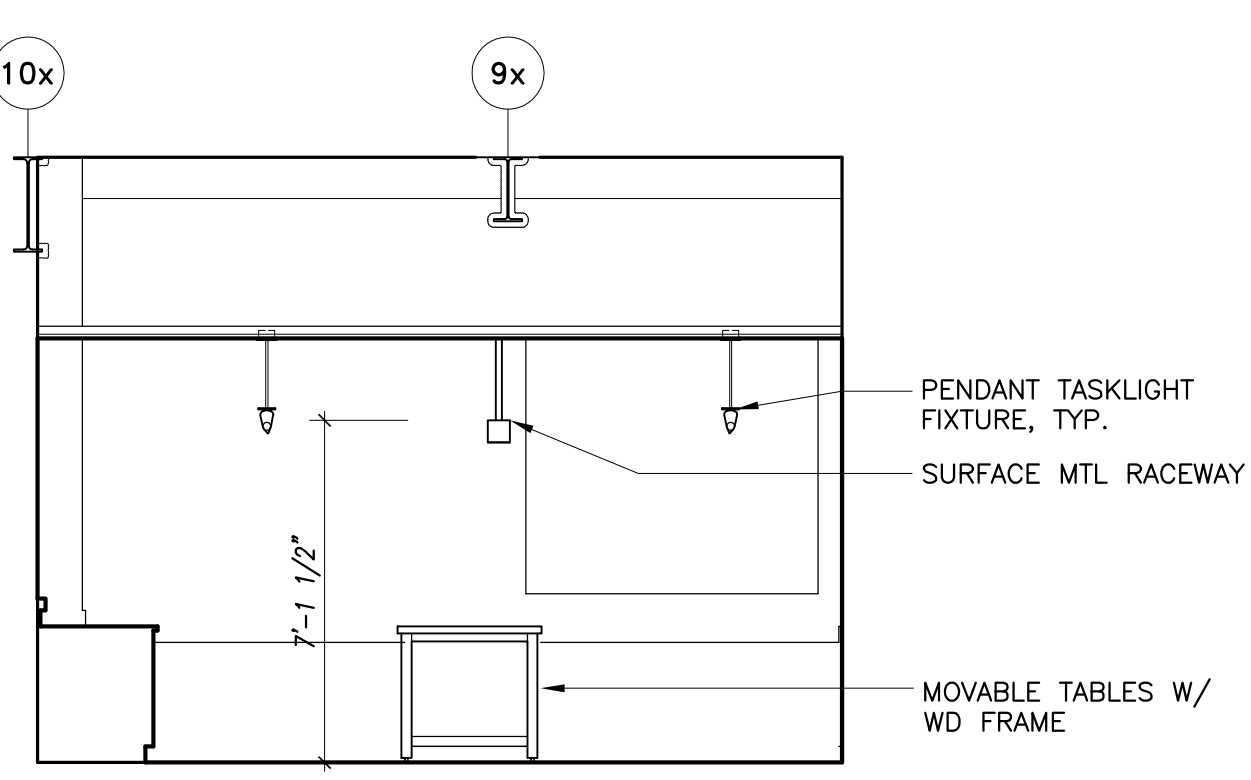


03 MATERIAL SCIENCE NANOSCIENCE LAB G106 EAST ELEV.
SCALE: 1/4" = 1'-0"

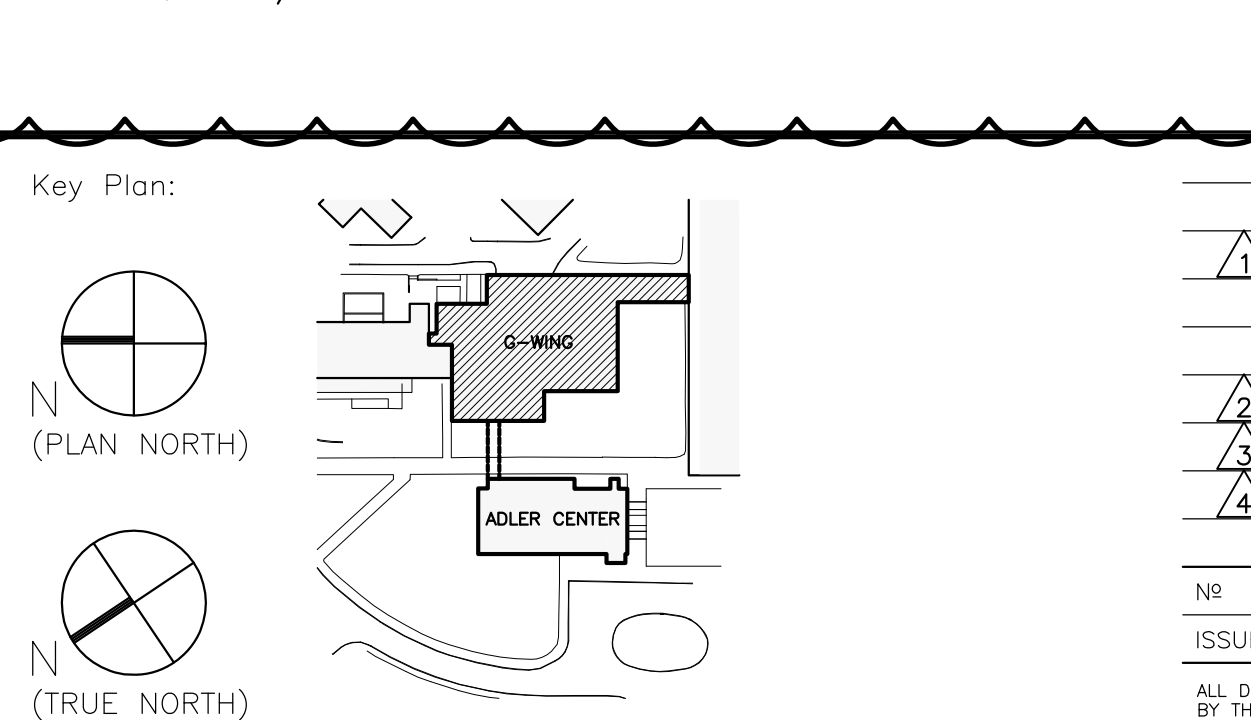

08 MATERIAL SCIENCE NANOSCIENCE LAB G106 SOUTH ELEVATION
SCALE: 1/4" = 1'-0"

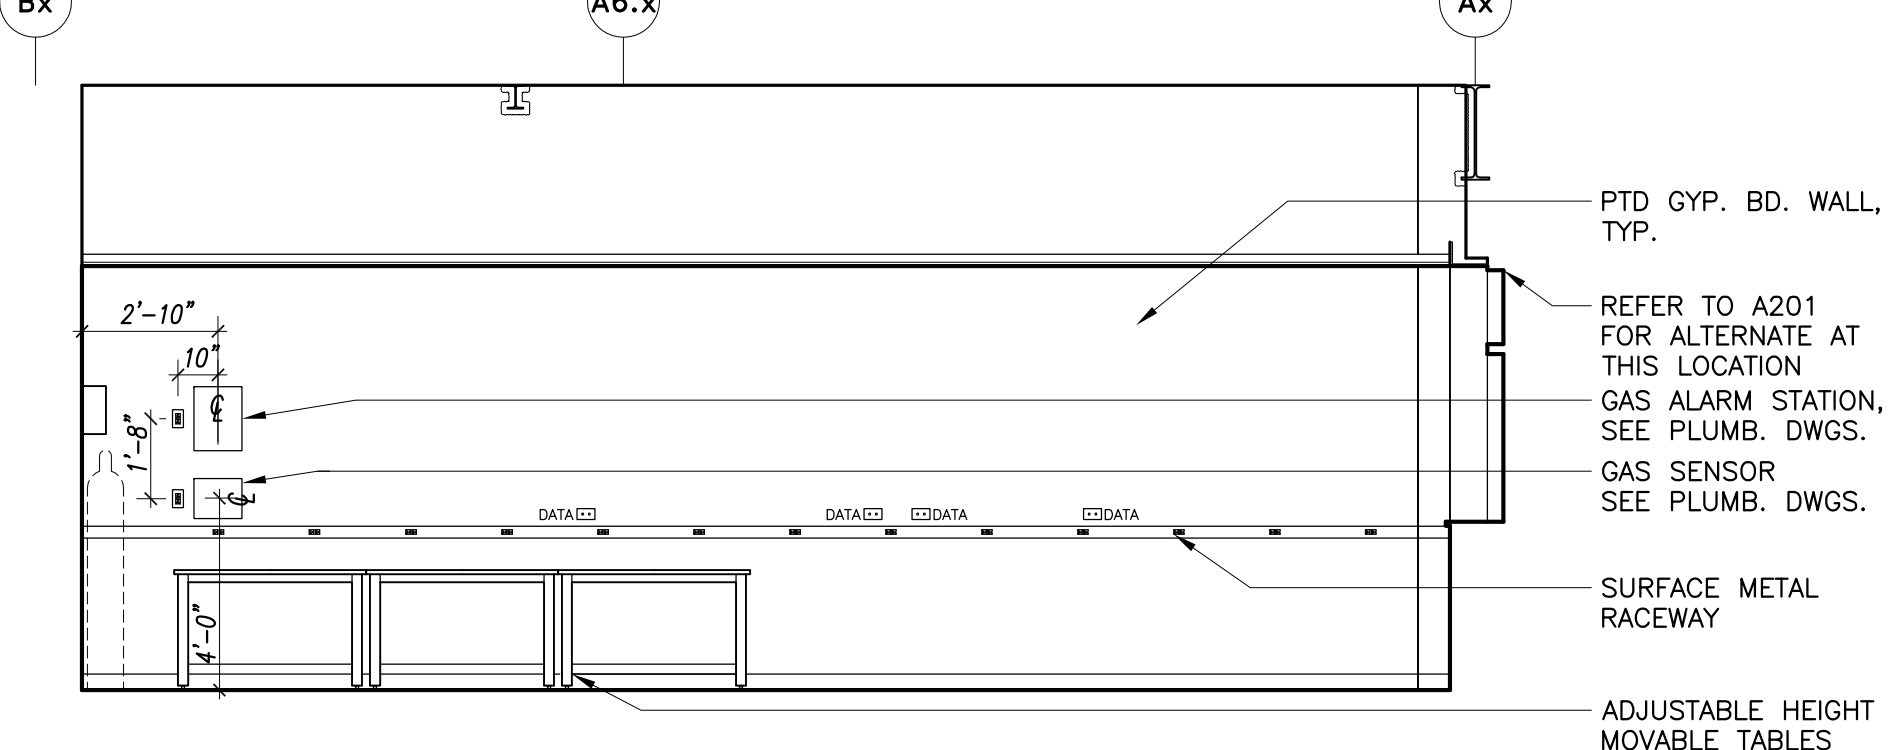

06 MATERIAL SCIENCE NANOSCIENCE LAB G106 NORTH ELEVATION
SCALE: 1/4" = 1'-0"

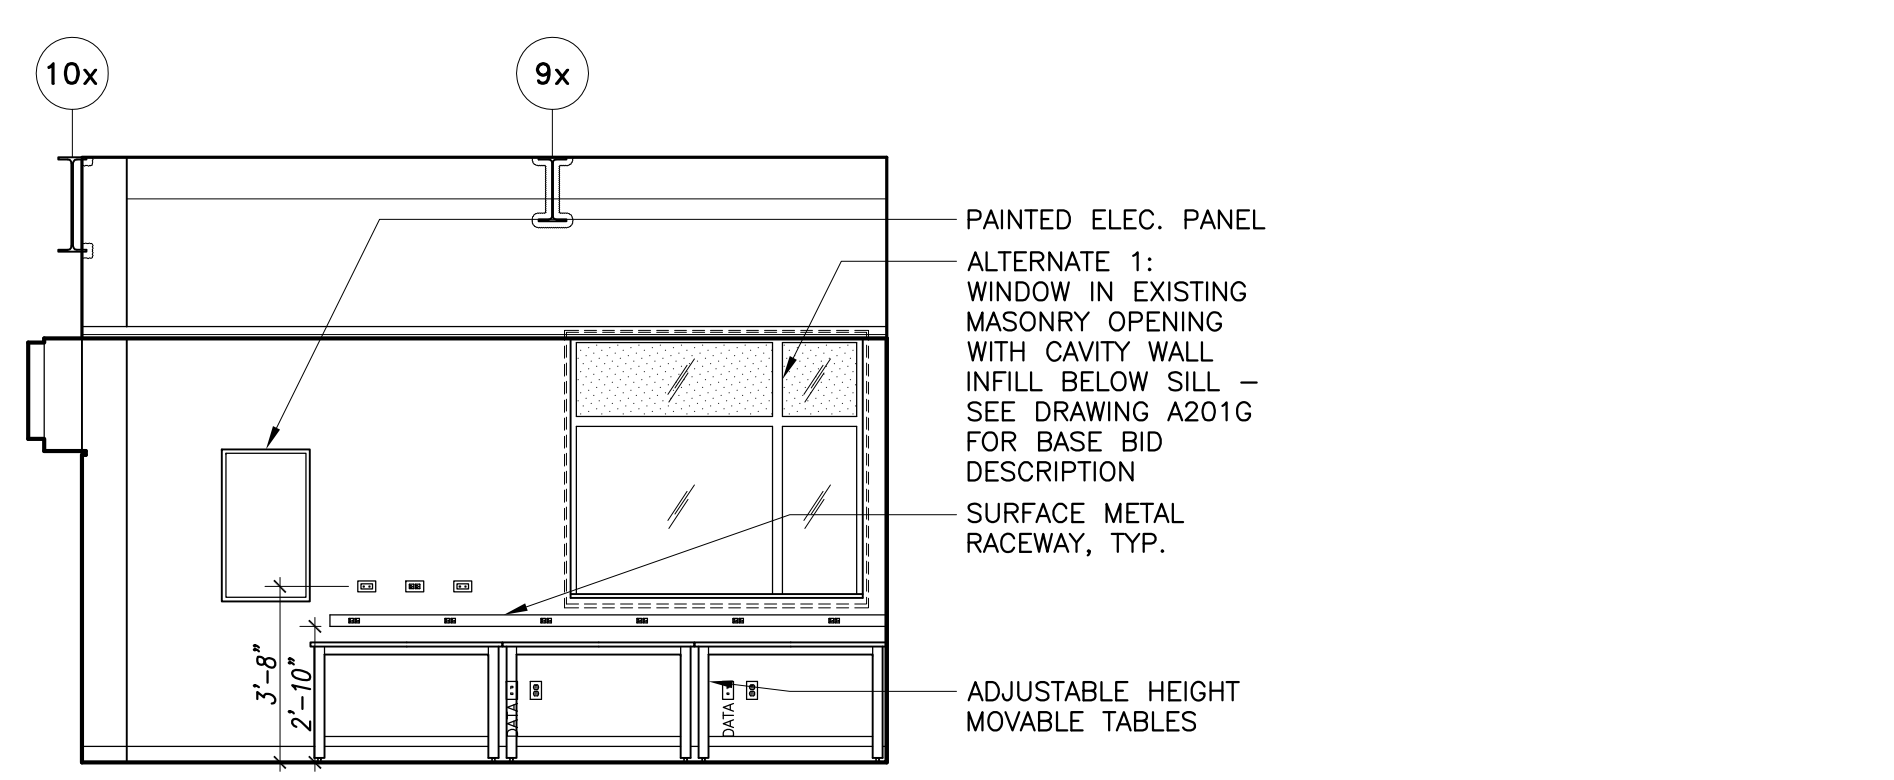

04 MATERIAL SCIENCE NANOSCIENCE LAB G106 EAST ELEVATION
SCALE: 1/4" = 1'-0"

GENERAL NOTE:
1. SEE A9.01 & A9.02 FOR ARCHITECTURAL WOODWORK, INTERIOR COLOR SCHEDULE & ABBREVIATIONS.
2. IN ROOM G106 INSTALL SPRAY FOAM INSULATION OVER ENTIRE INTERIOR FACE NORTH & EAST EXTERIOR WALLS.

KEY PLAN - FIRST FLOOR G-WING
SCALE: NO SCALE

