




05 G-WING TYPICAL EXTERIOR WALL SECTION @ 1ST FLOOR FLASHING
SCALE: 1 1/2" = 1'-0"

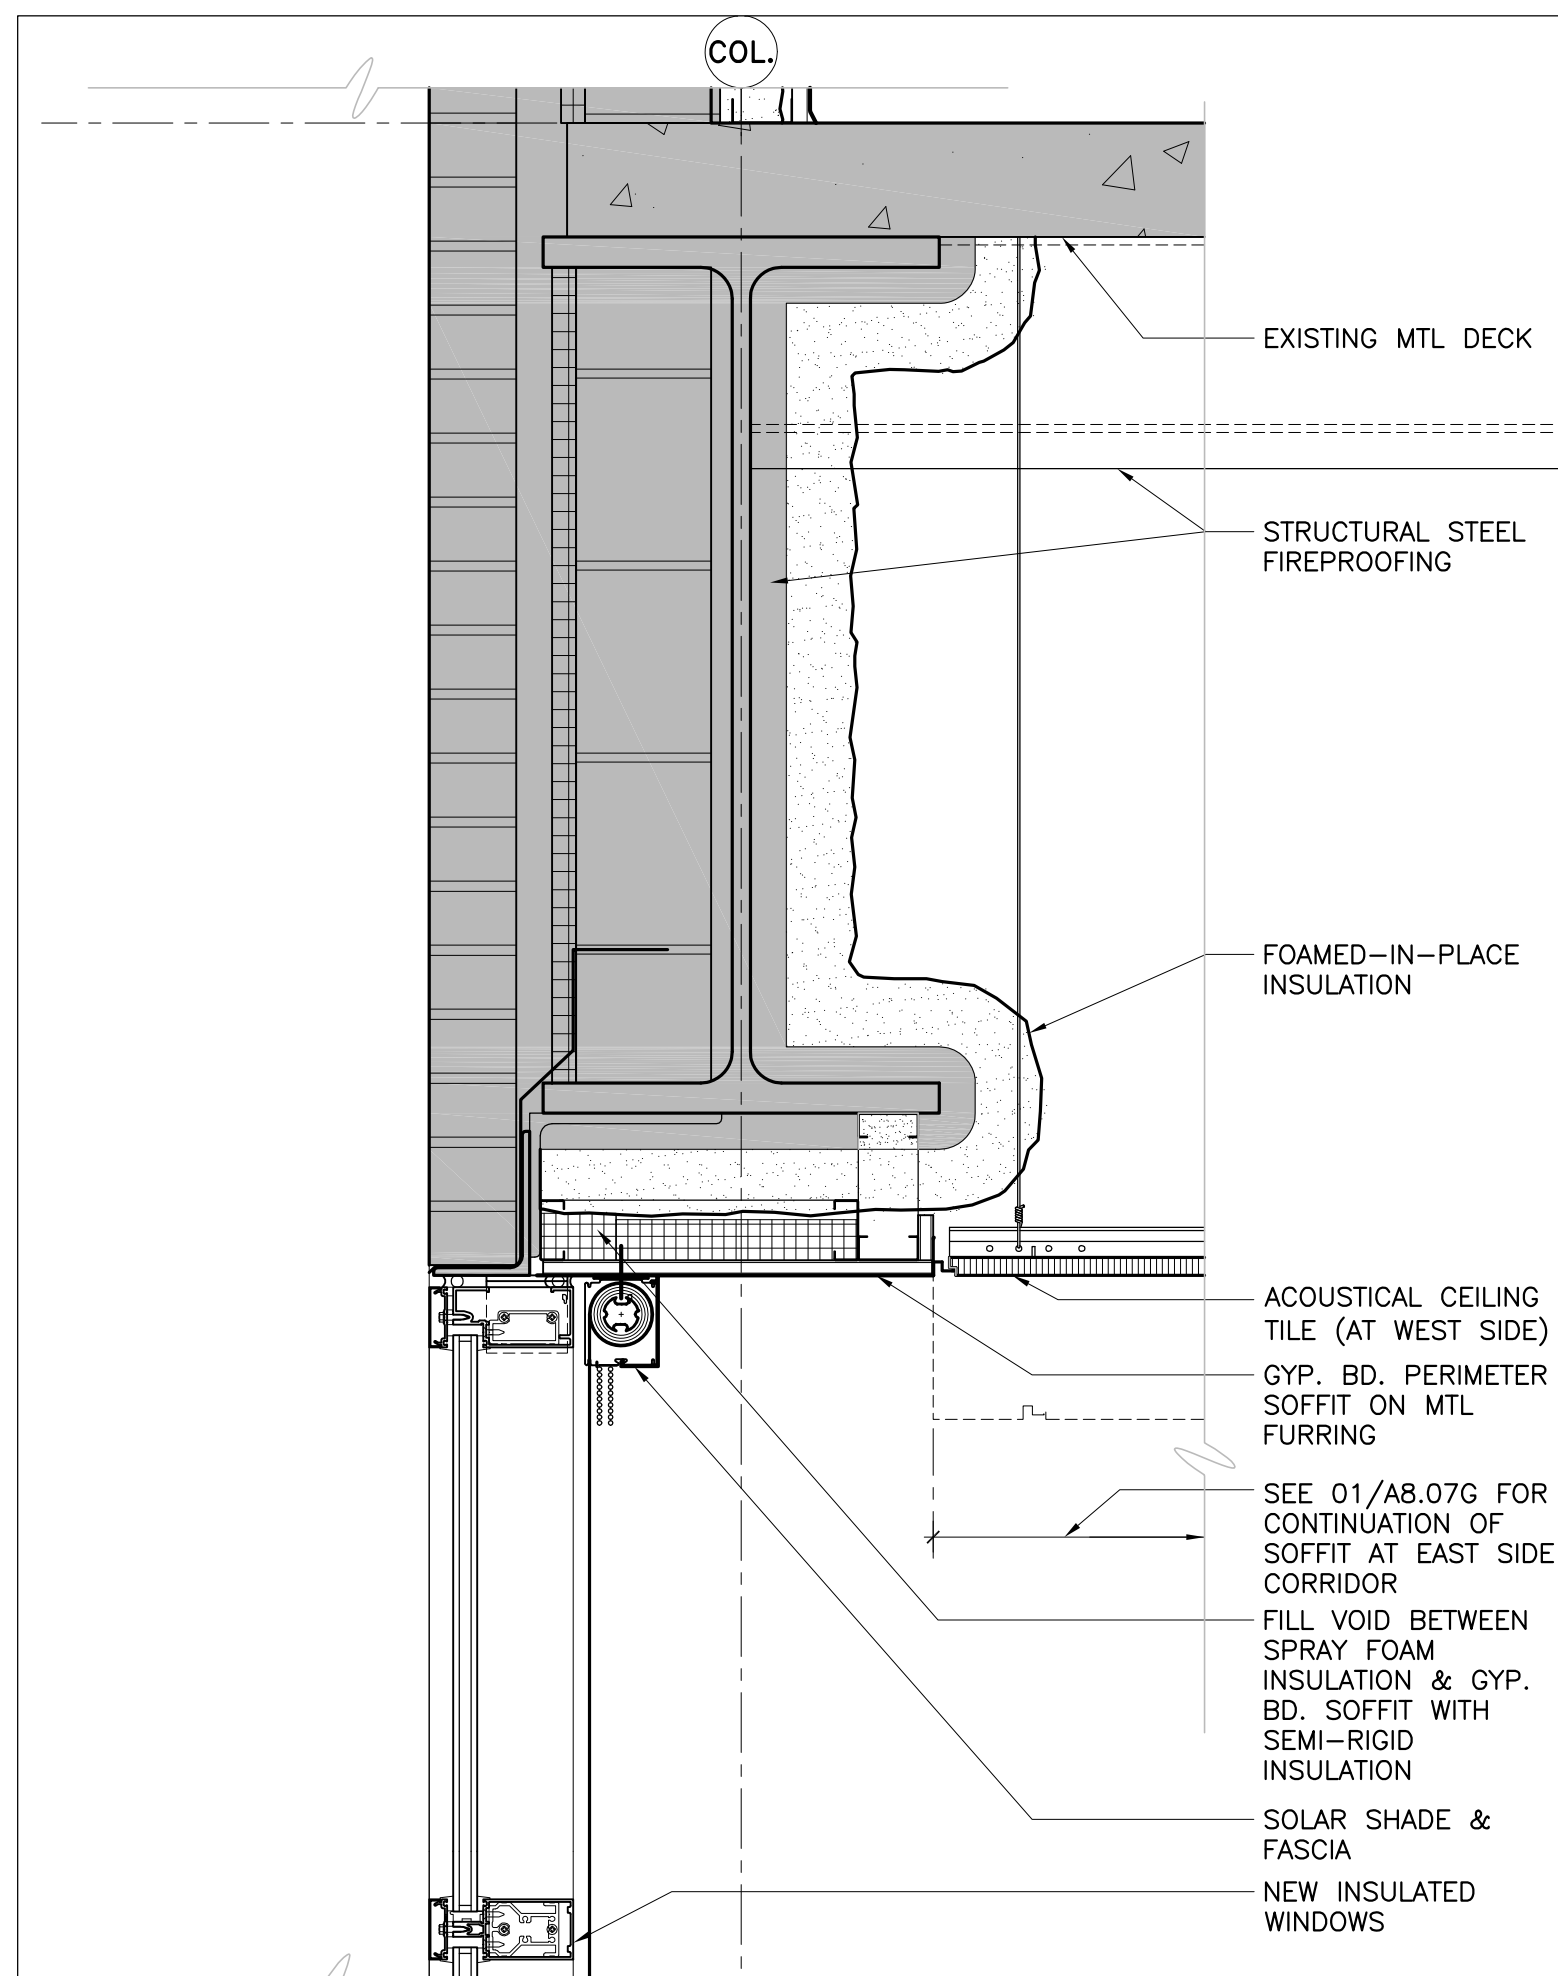


06 G-WING EXT. WALL SECTION-2ND FLR. BETWEEN COL. LINE 2x-3x
SCALE: 1 1/2" = 1'-0"

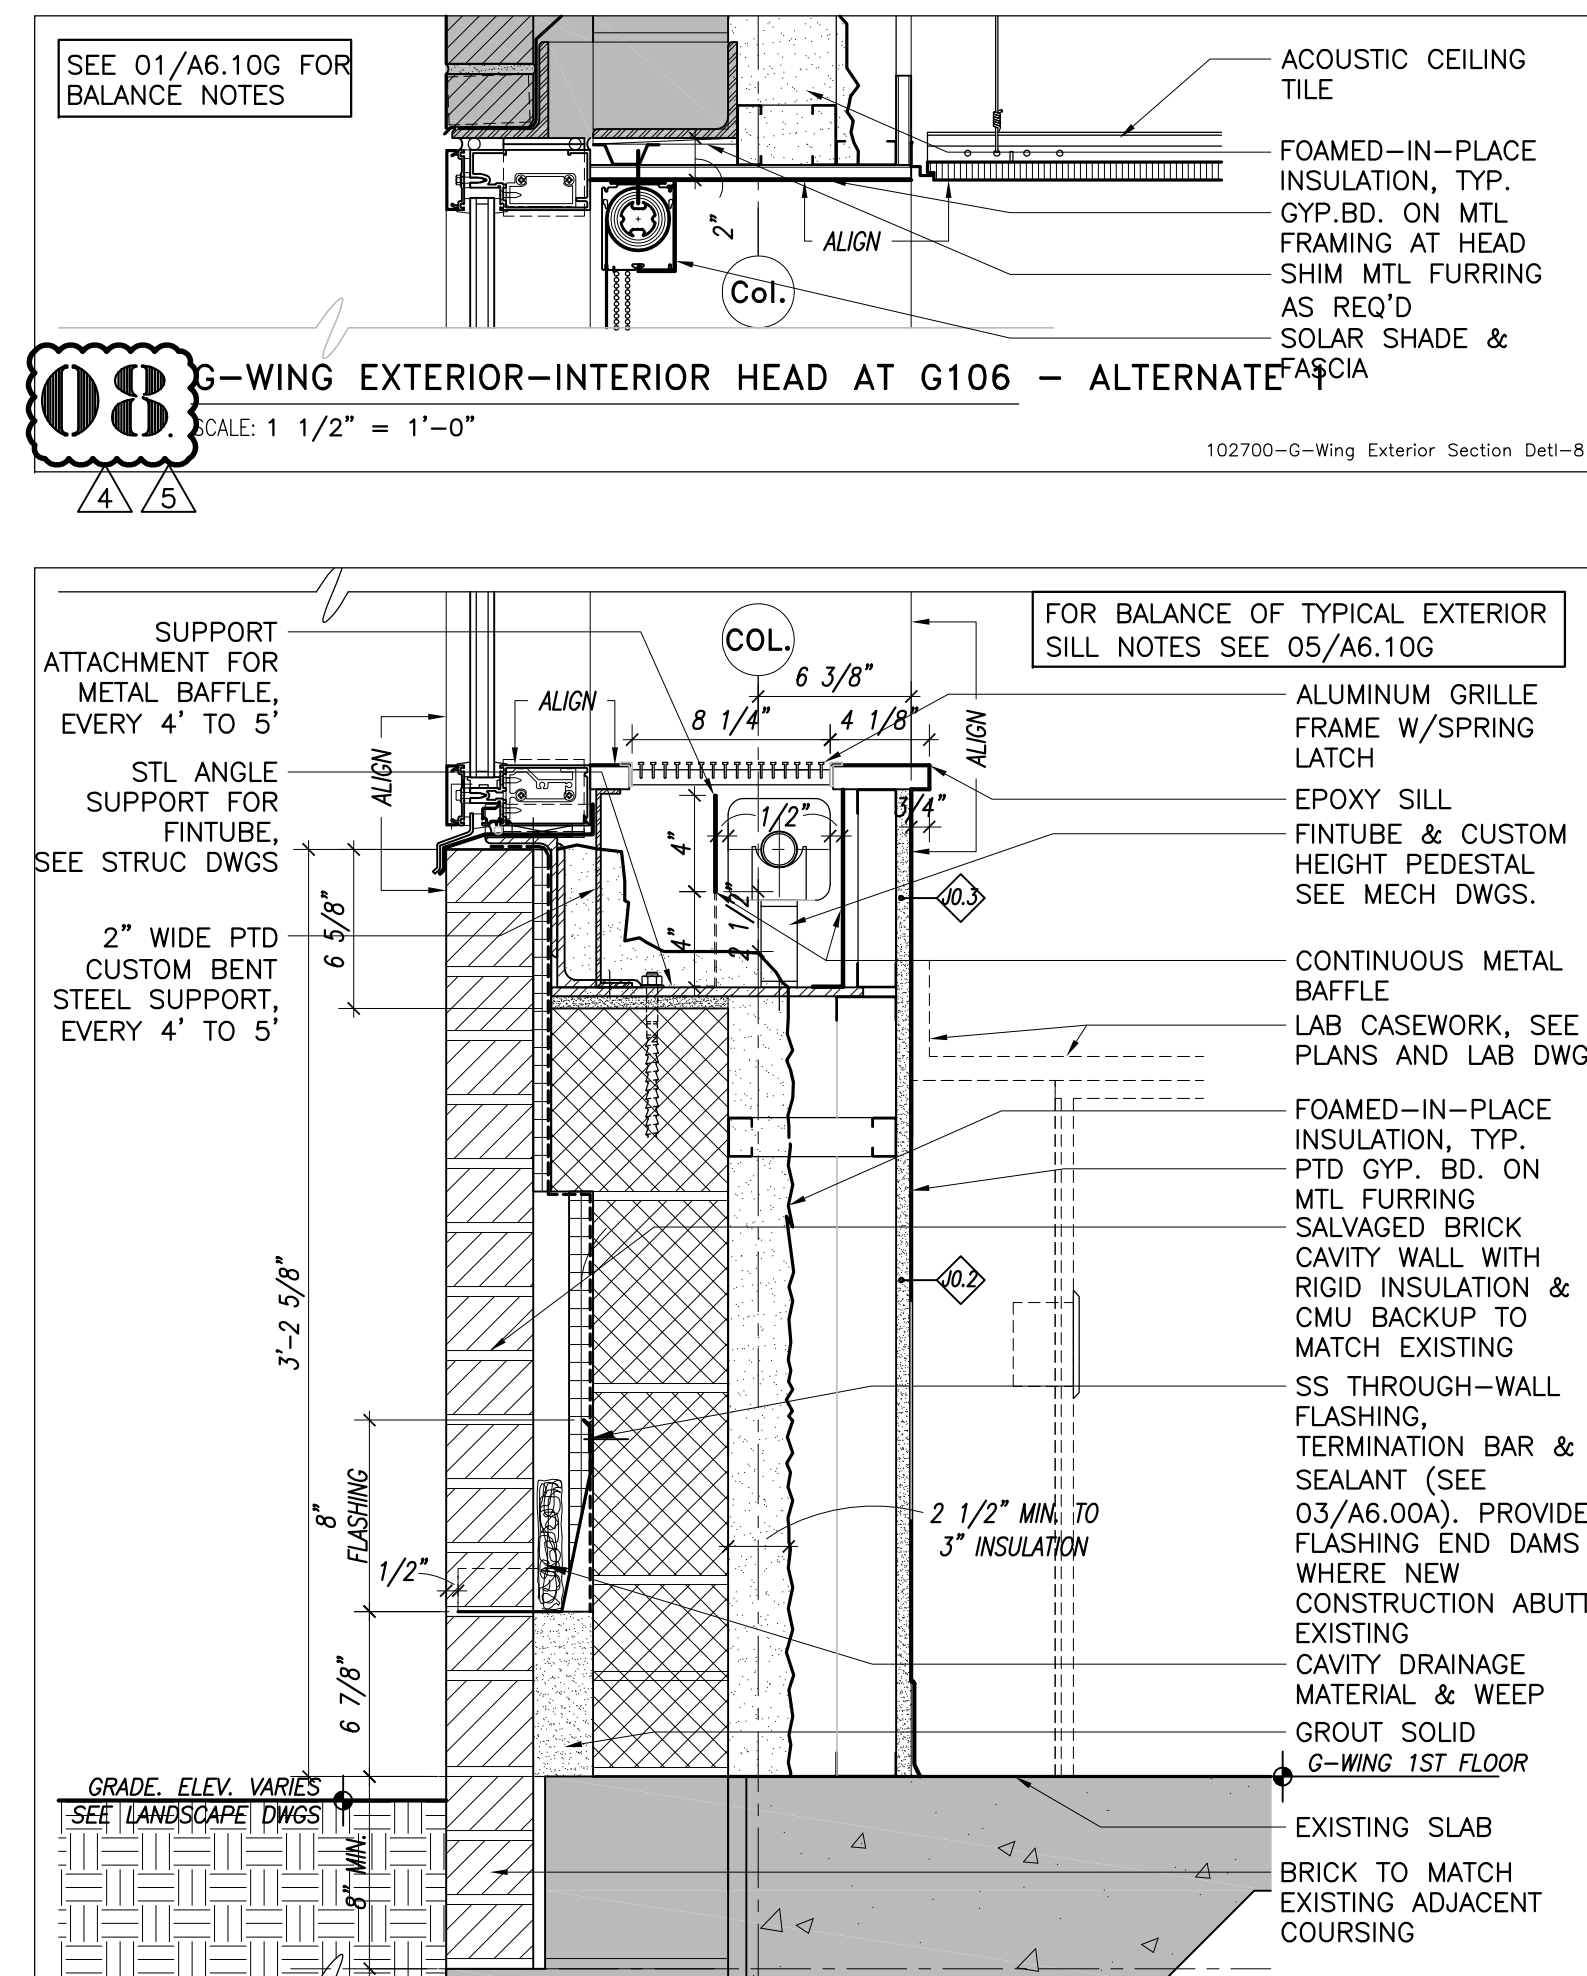


07 G-WING EXTERIOR-INTERIOR SILL AT G106 - ALTERNATE 1
SCALE: 1 1/2" = 1'-0"

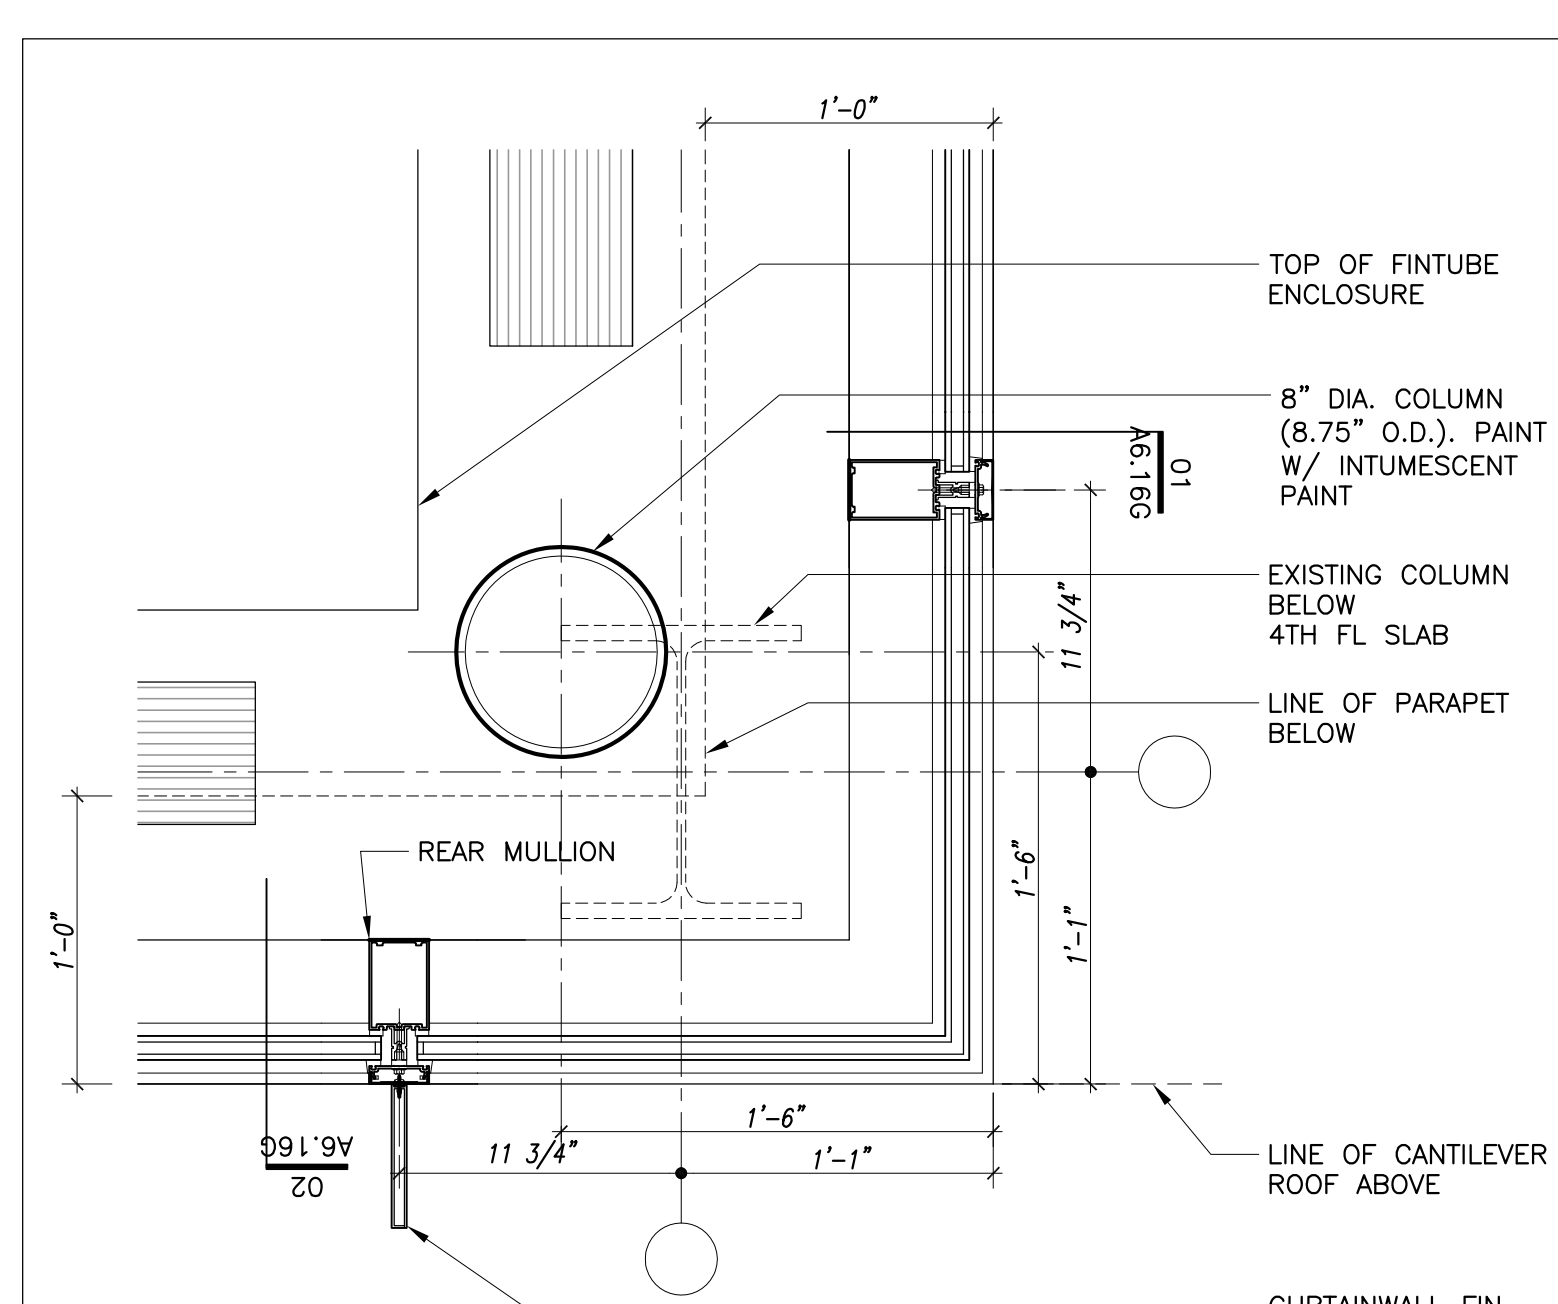


03 G WING PLAN DETAIL AT SE CORNER 4TH FLOOR
SCALE: 1 1/2" = 1'-0"

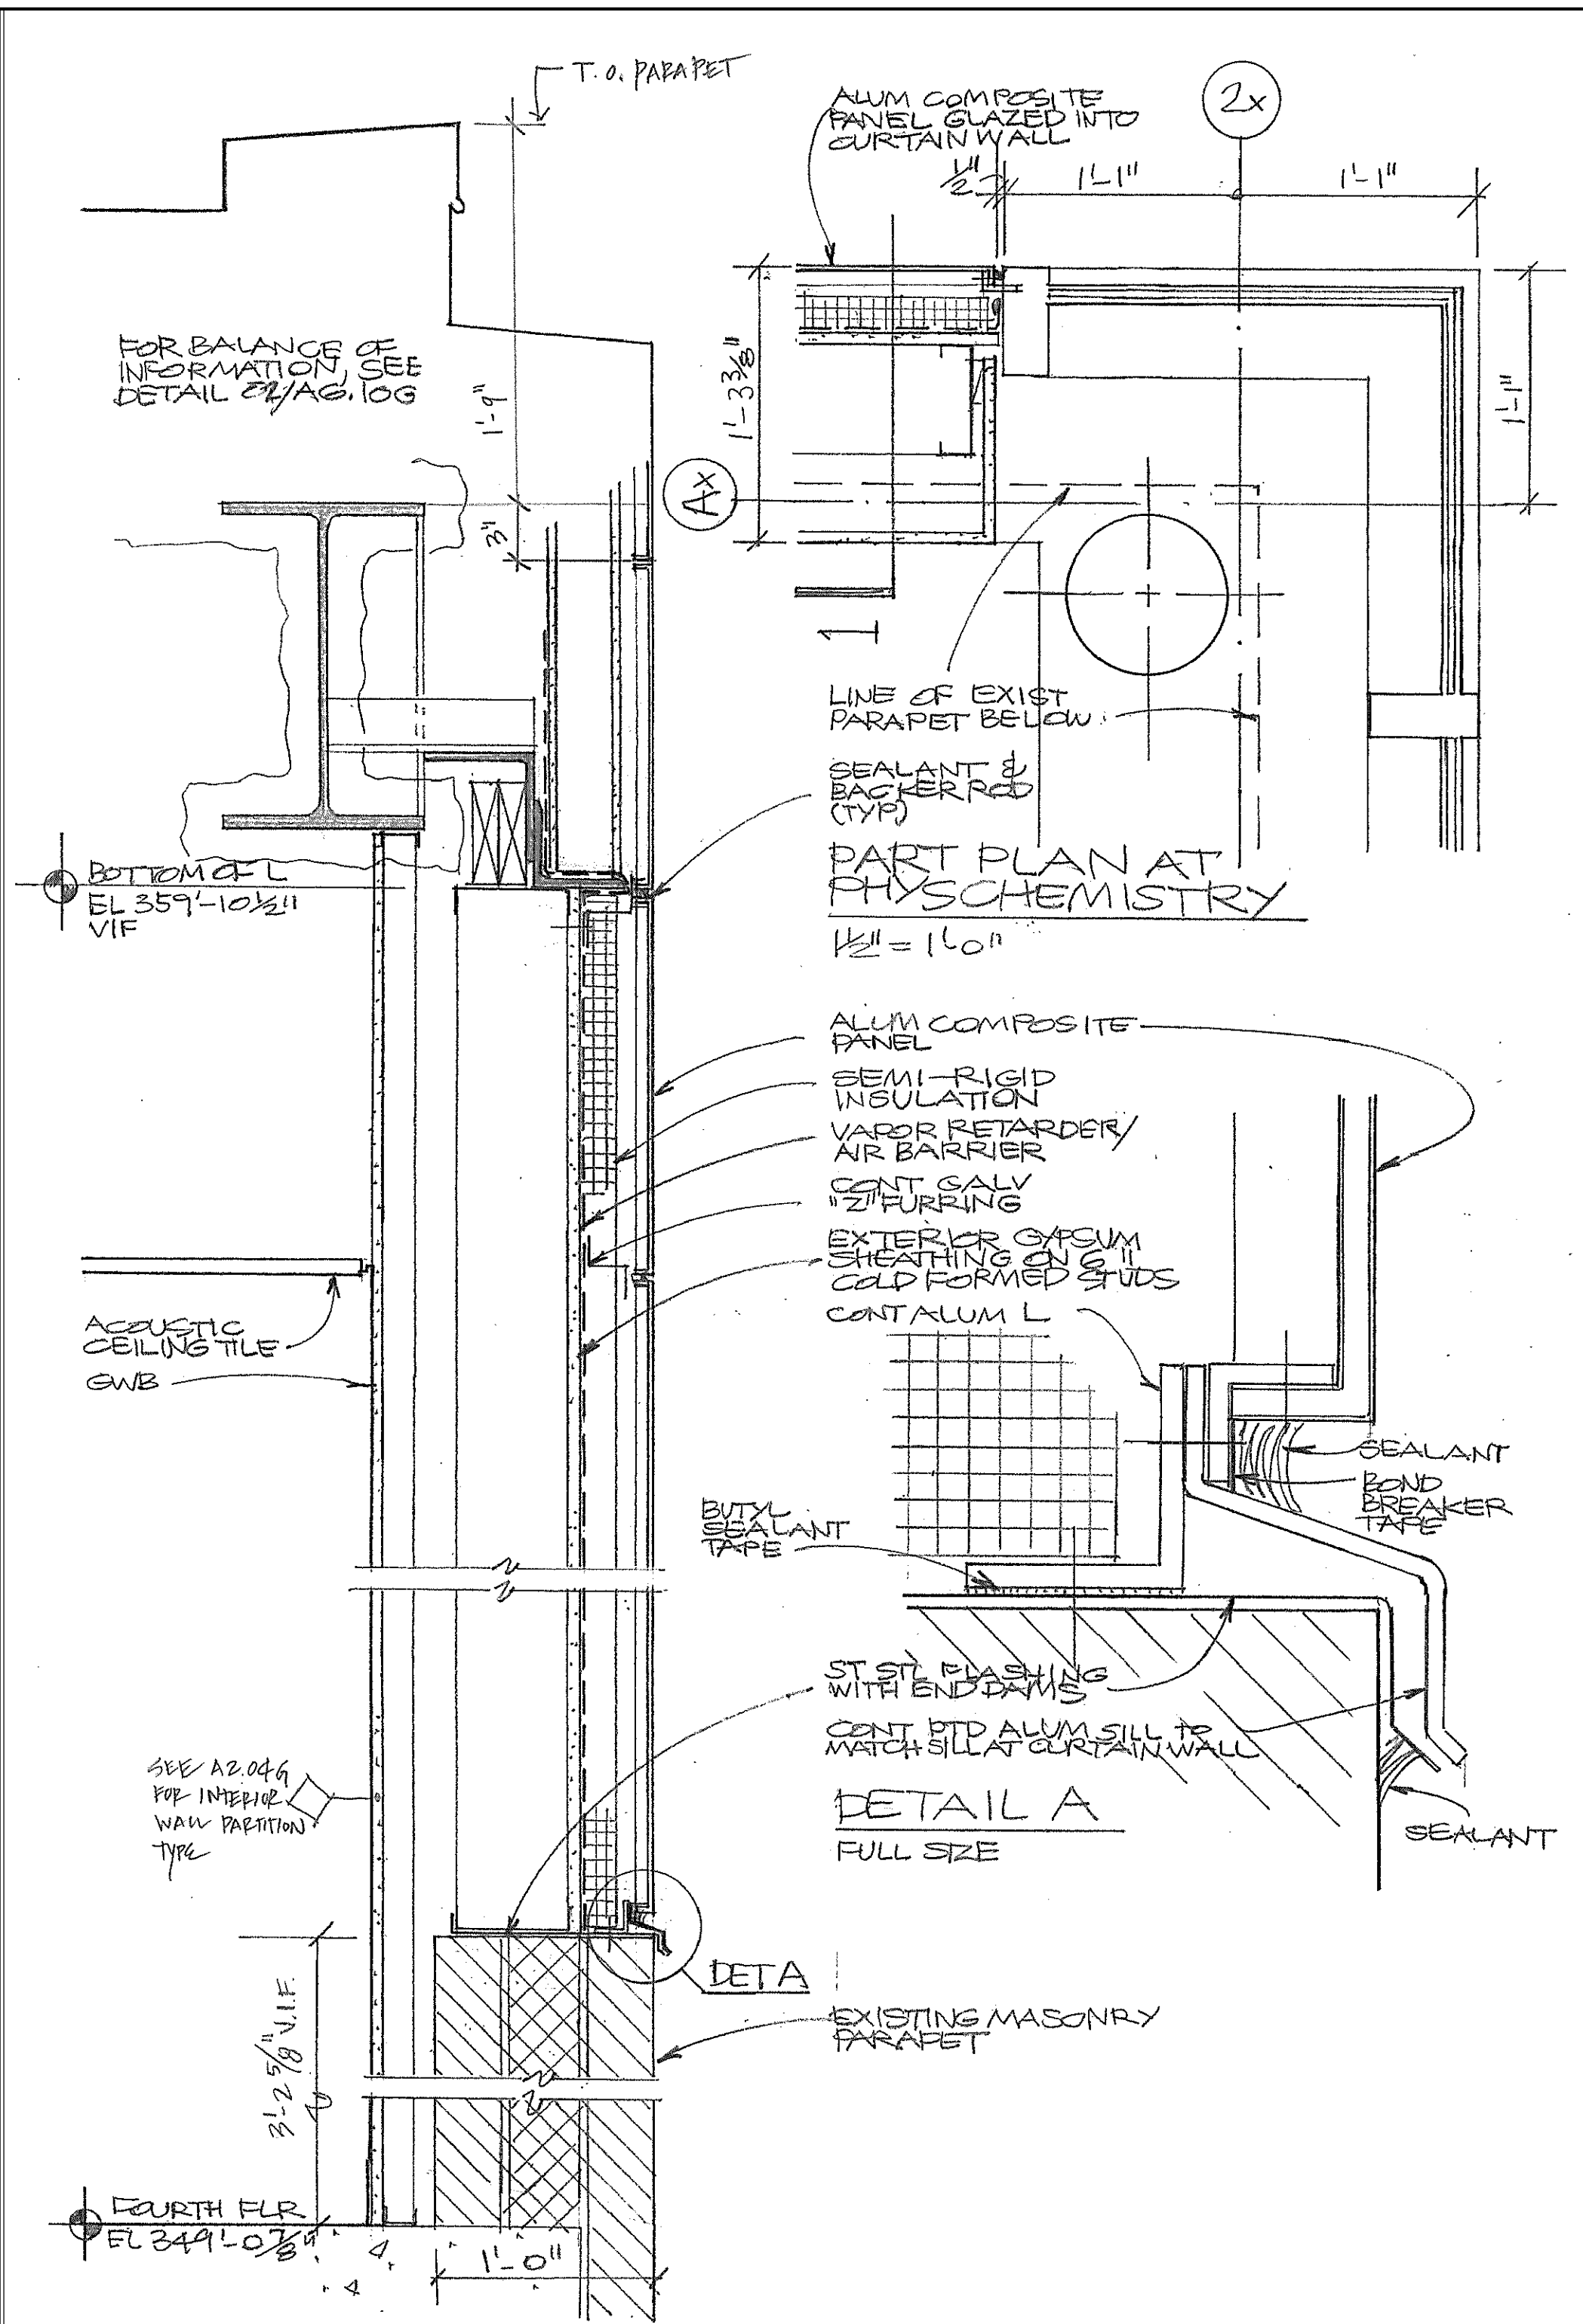

04 G-WING EAST WALL SECTION & PLAN
SCALE: 1 1/2" = 1'-0"

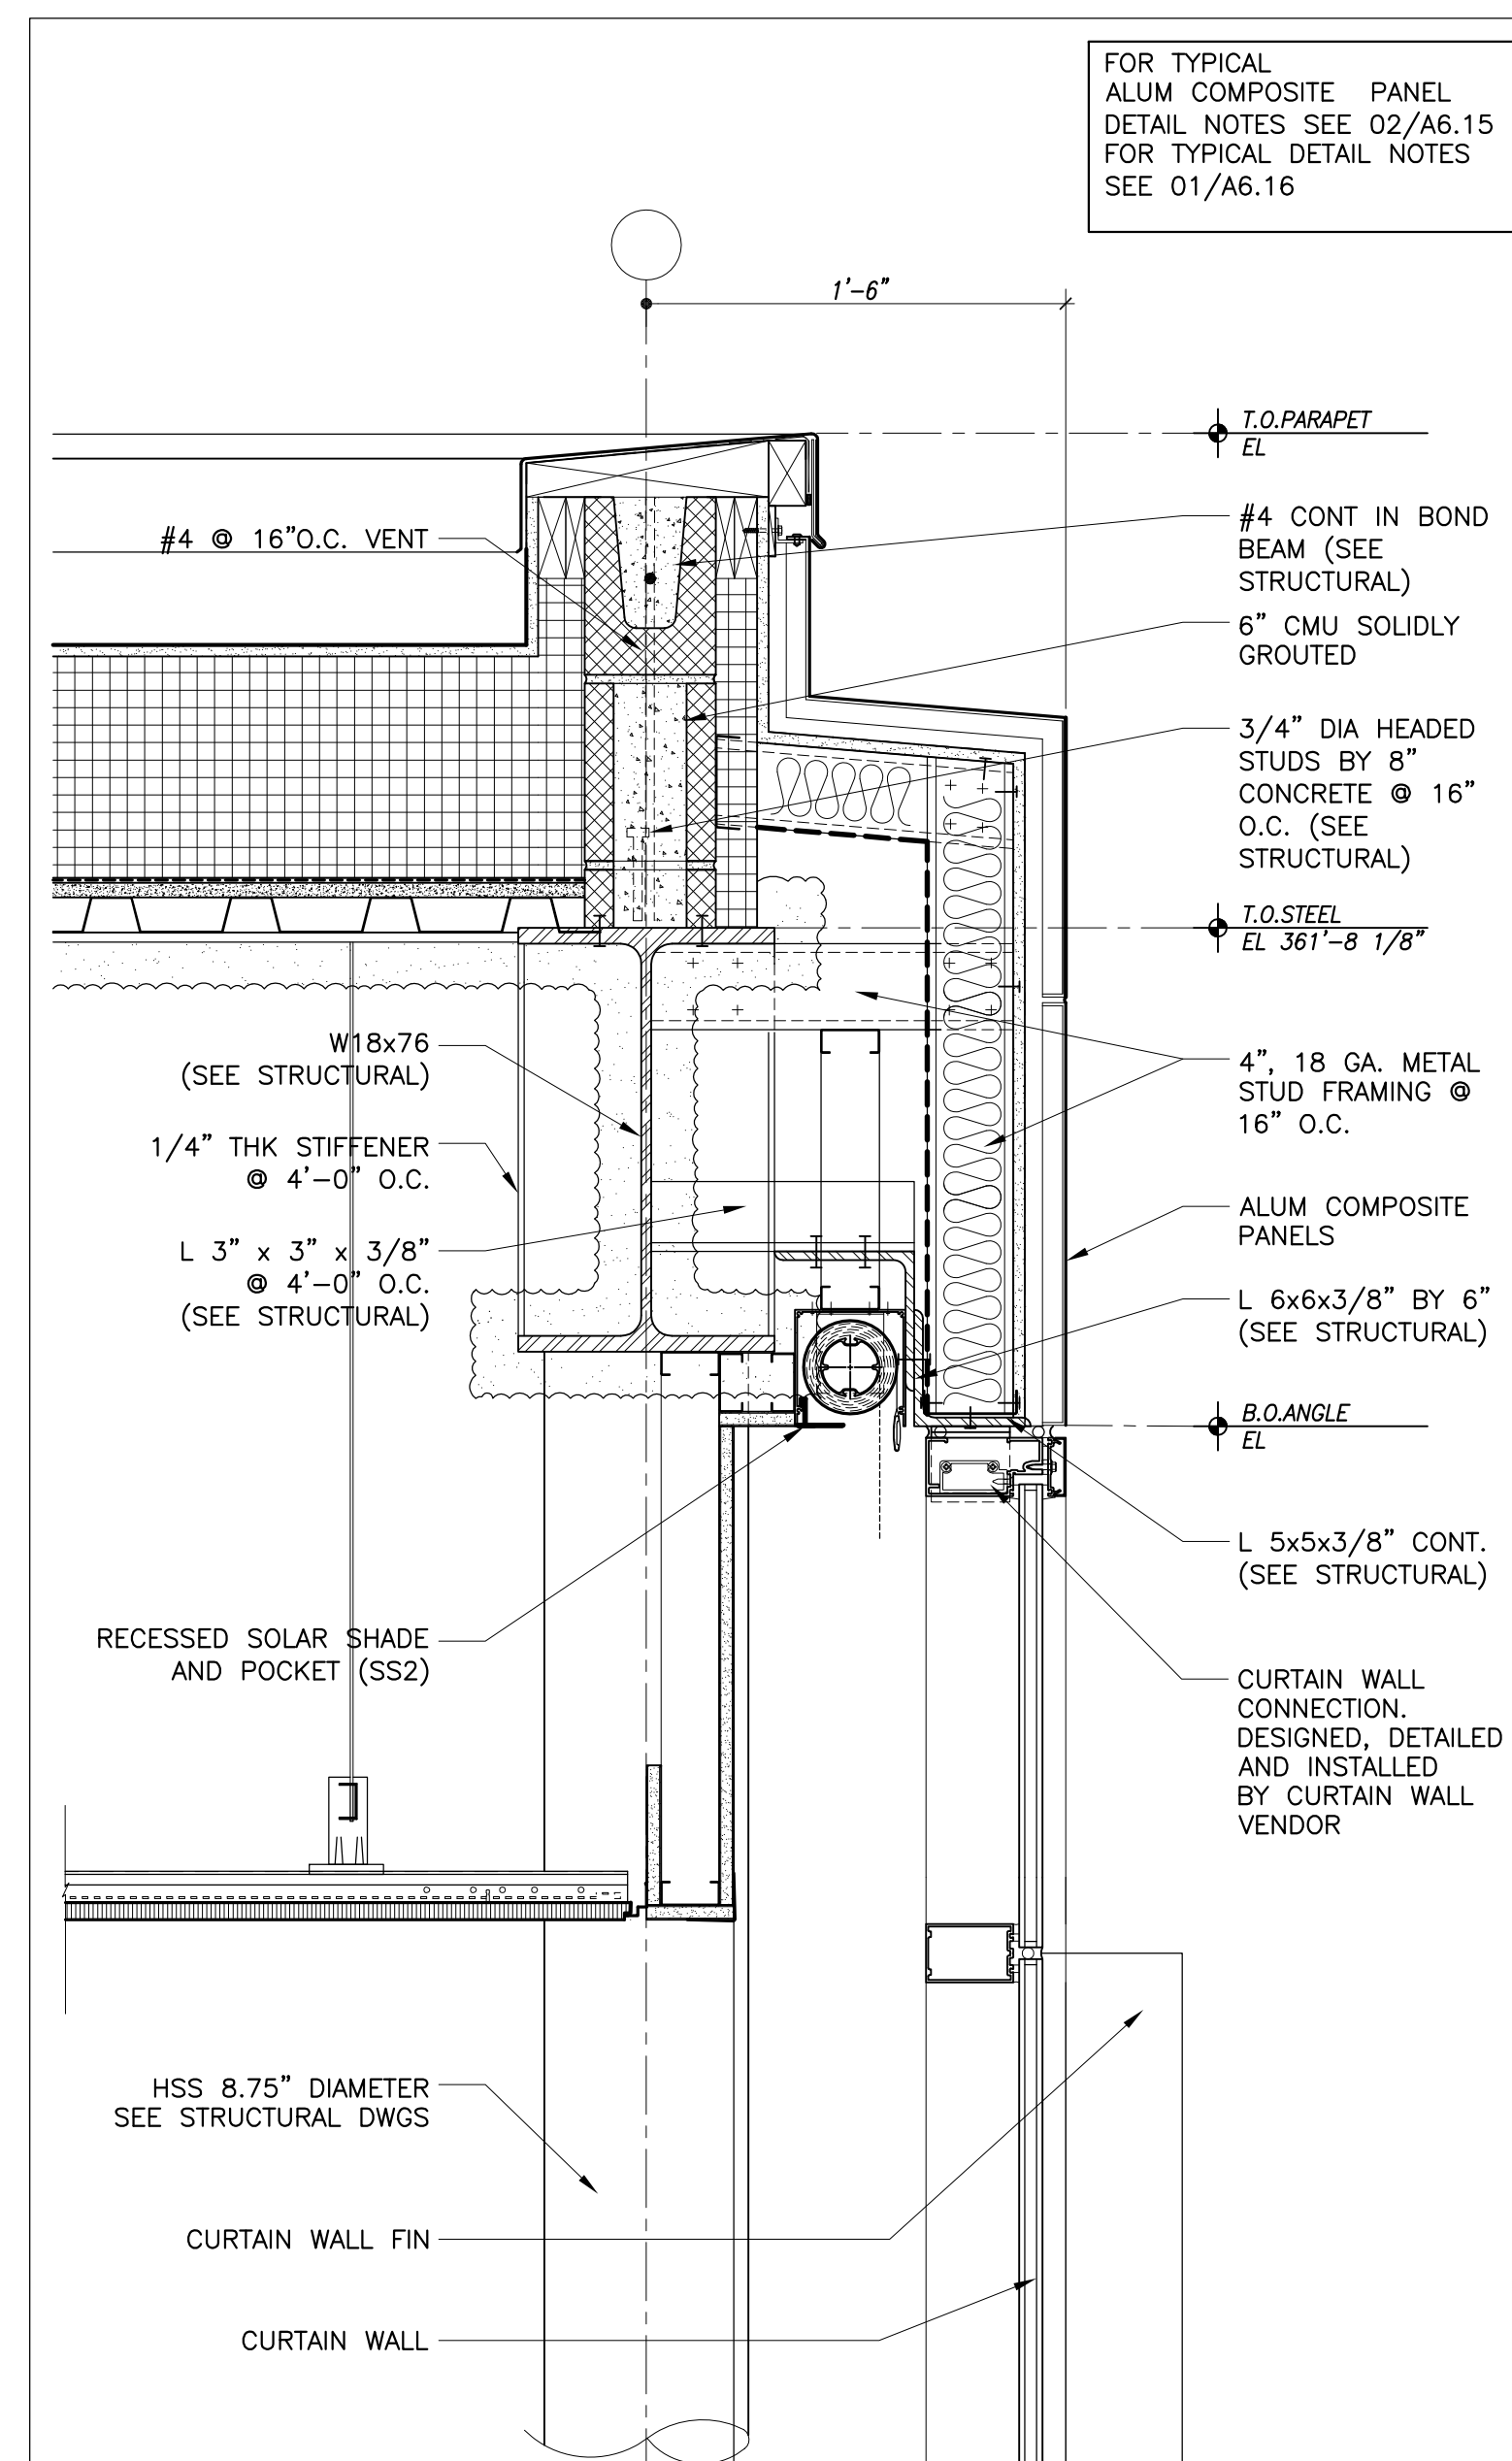

02 G-WING SECTION AT ROOF
SCALE: 1 1/2" = 1'-0"

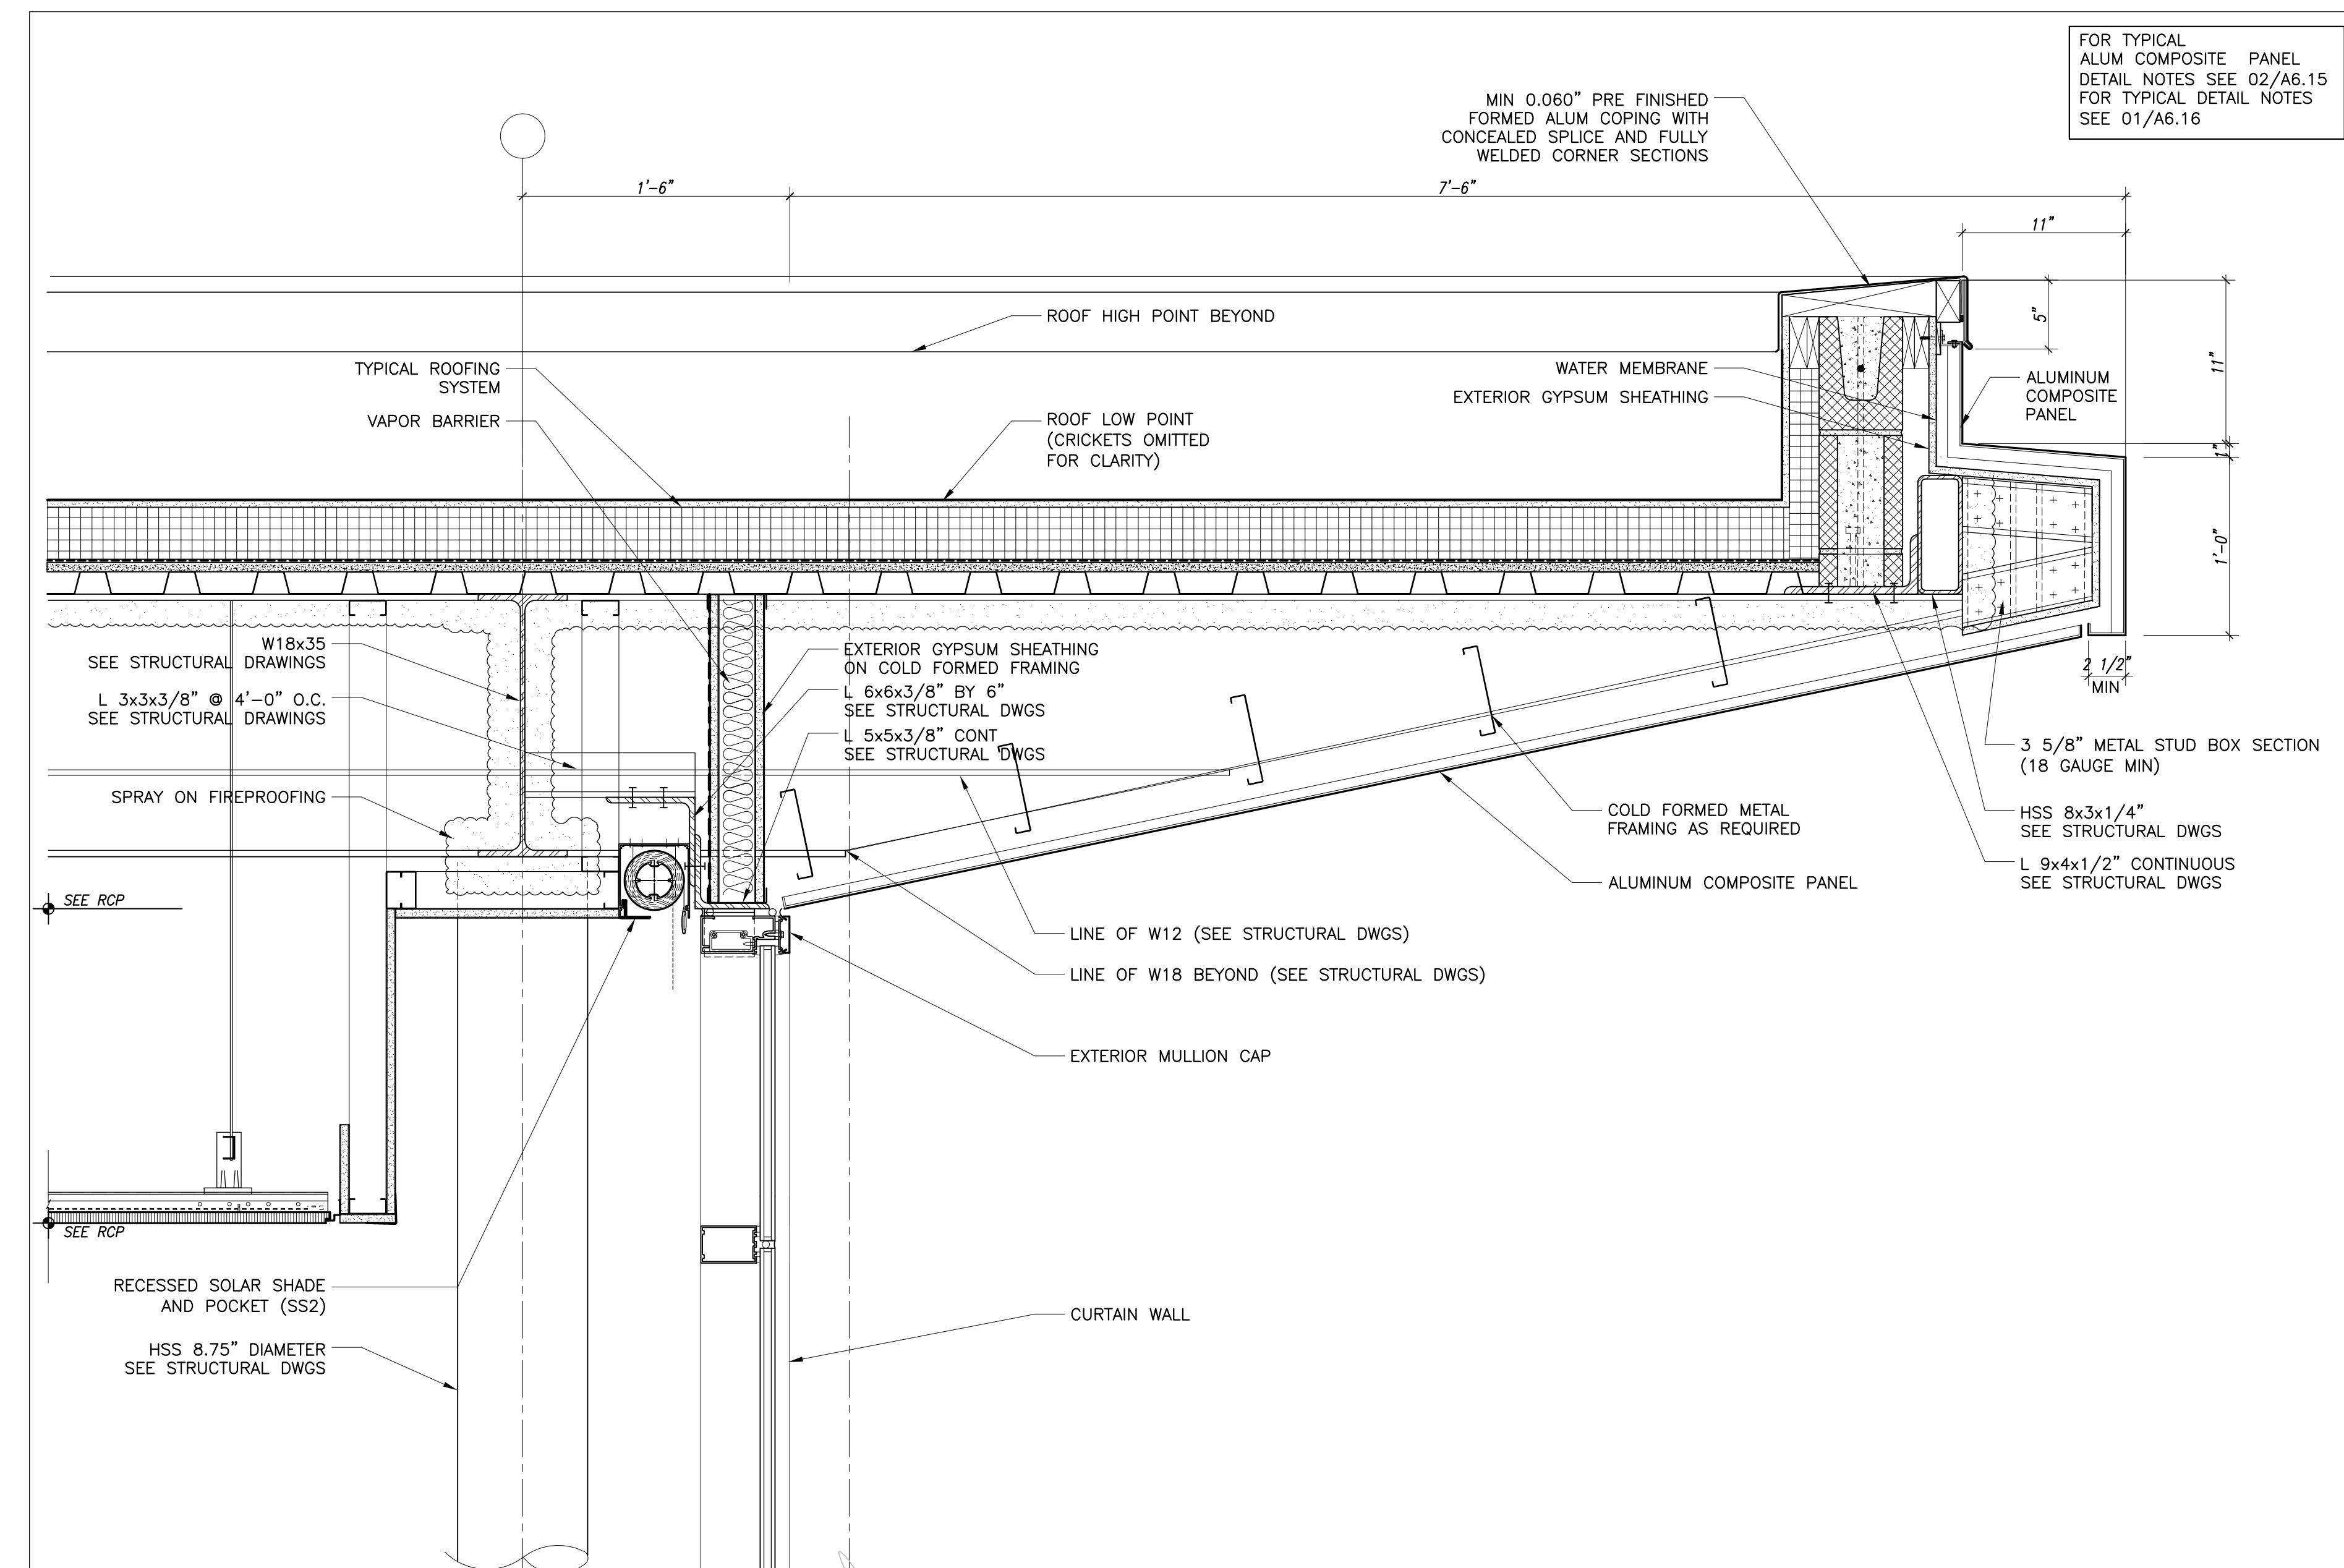

01 G-WING SECTION THRU CANTILEVER ROOF
SCALE: 1 1/2" = 1'-0"



OWNER:
Ramapo College of New Jersey
505 Ramapo Valley Road
Mahwah, New Jersey 07430-1630

CONSTRUCTION MANAGERS:
Cambridge Construction Management
335 East Main Street
Somerville, NJ 08876
908-253-9500

ARCHITECT:
Mitchell/Giurgola Architects, LLP
630 Ninth Avenue, Suite 711
New York, NY 10003
212 529 2263

MEP ENGINEER:
Joseph R. Loring & Associates, Inc.
219 Pennsylvania Plaza
New York, NY 10001
212 563 7400


STRUCTURAL ENGINEER:
Yarael A. Selinuk PC
228 East 45th Street 2nd Floor
New York, NY 10017
212 687 2233

LANDSCAPE ARCHITECT:
Dirtworks, PC
200 Park Avenue South
New York, NY 10003
212 529 2263

SITE CIVIL ENGINEER:
Langan Engineering
619 River Drive Center 1
Elmwood Park, NJ 07407-1338
201 794 6900

AV CONSULTANT:
Cerami & Associates
404 Fifth Avenue
New York, NY 10018
212 370 1776

Key Plan:

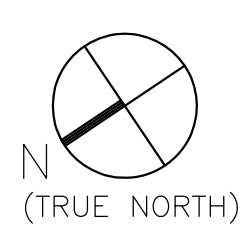

6/8/12	DCA FILING
7/19/12	ISSUED FOR BID
1/15/13	ISSUED FOR CONSTRUCTION
7/28/13	ASI #009
1/09/14	CONFORMANCE SET
11/03/14	ASI #033
1/6/15	ASI #036
12/7/15	BULLETIN #35
8/12/16	AS-BUILT CONSTRUCTION DOCUMENTS
2/17/17	BULLETIN #35 (REVISED)

ALL DIMENSIONS AND EXISTING CONDITIONS SHALL BE CHECKED AND VERIFIED BY THE CONTRACTOR BEFORE PROCEEDING WITH THE WORK.

Project:
G-WING RENOVATION & ADLER CENTER

Submission:
CONSTRUCTION DOCUMENTS

Drawing Title:
EXTERIOR DETAILS - G-WING

PROJECT NO: 102700
DATE: 6/8/12
SCALE: SCALE

A6.16G