



NOTE:
UNIT MODEL: C28-06-FKGO MANUFACTURED BY WILKERSON

**DETAIL OF COMBINATION AIR
FILTER/REGULATOR/LUBRICATION UNIT**
(NOT TO SCALE)

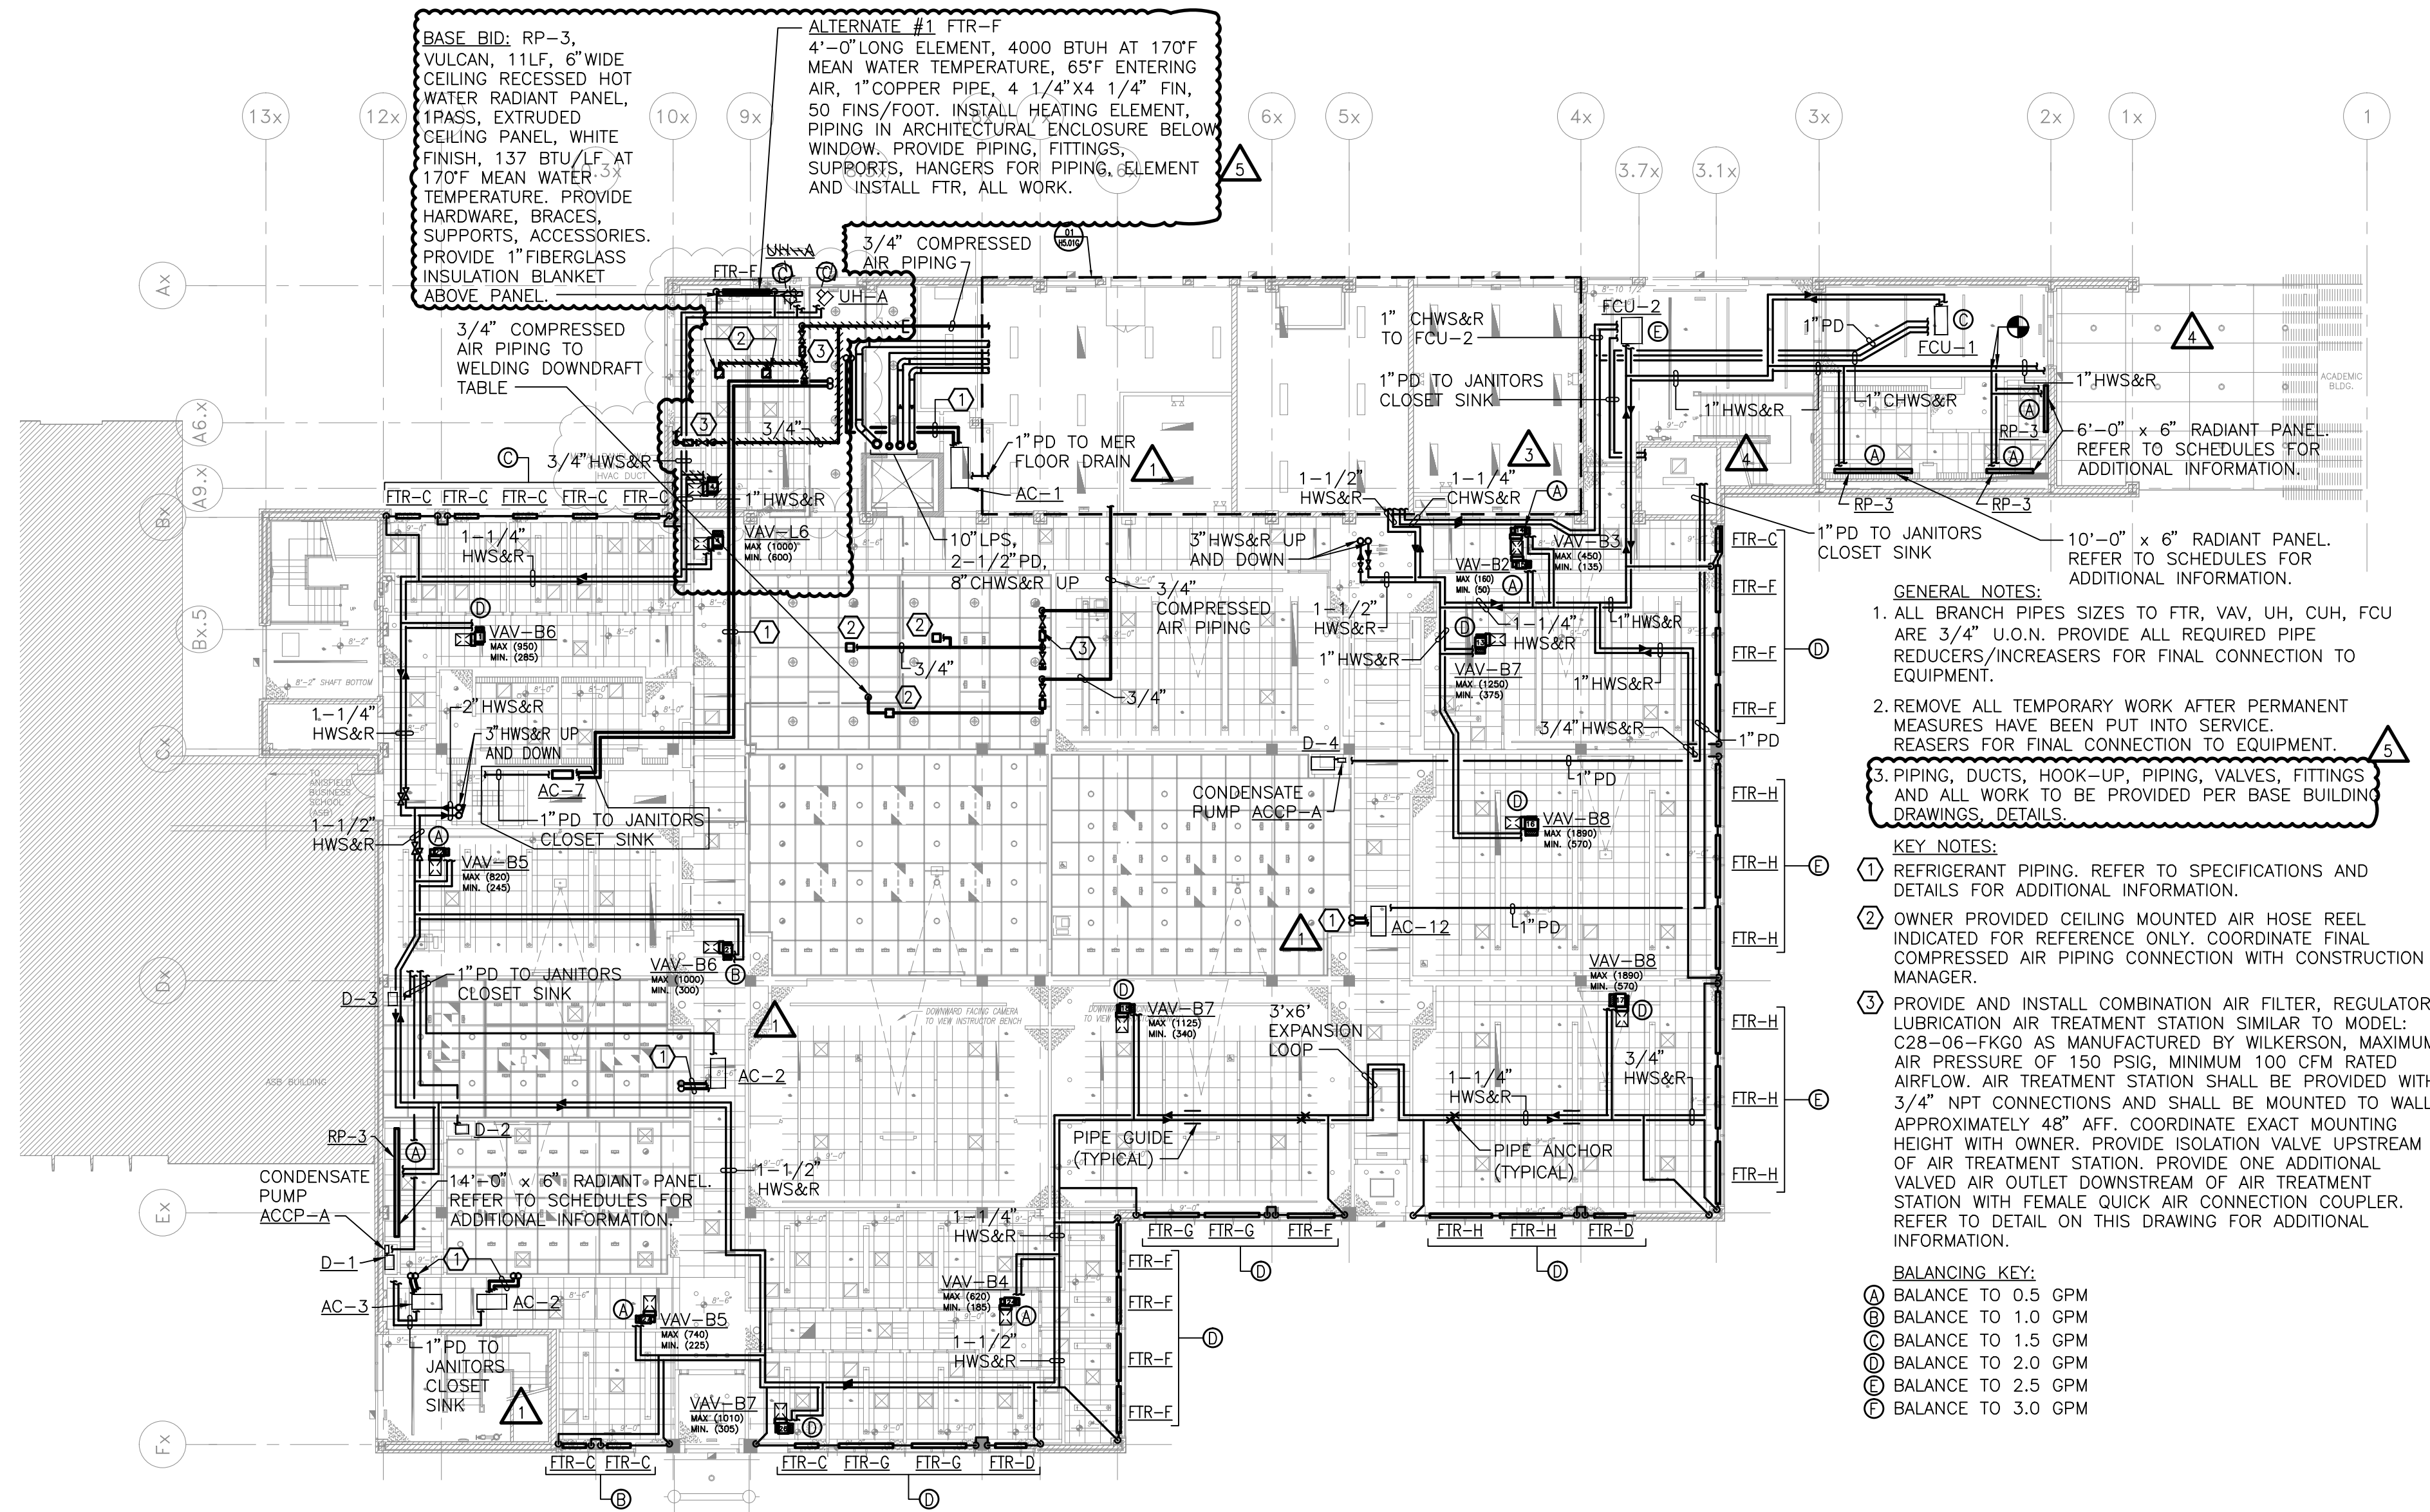

01 FIRST FLOOR PIPING PLAN
SCALE: 1/16\"/>

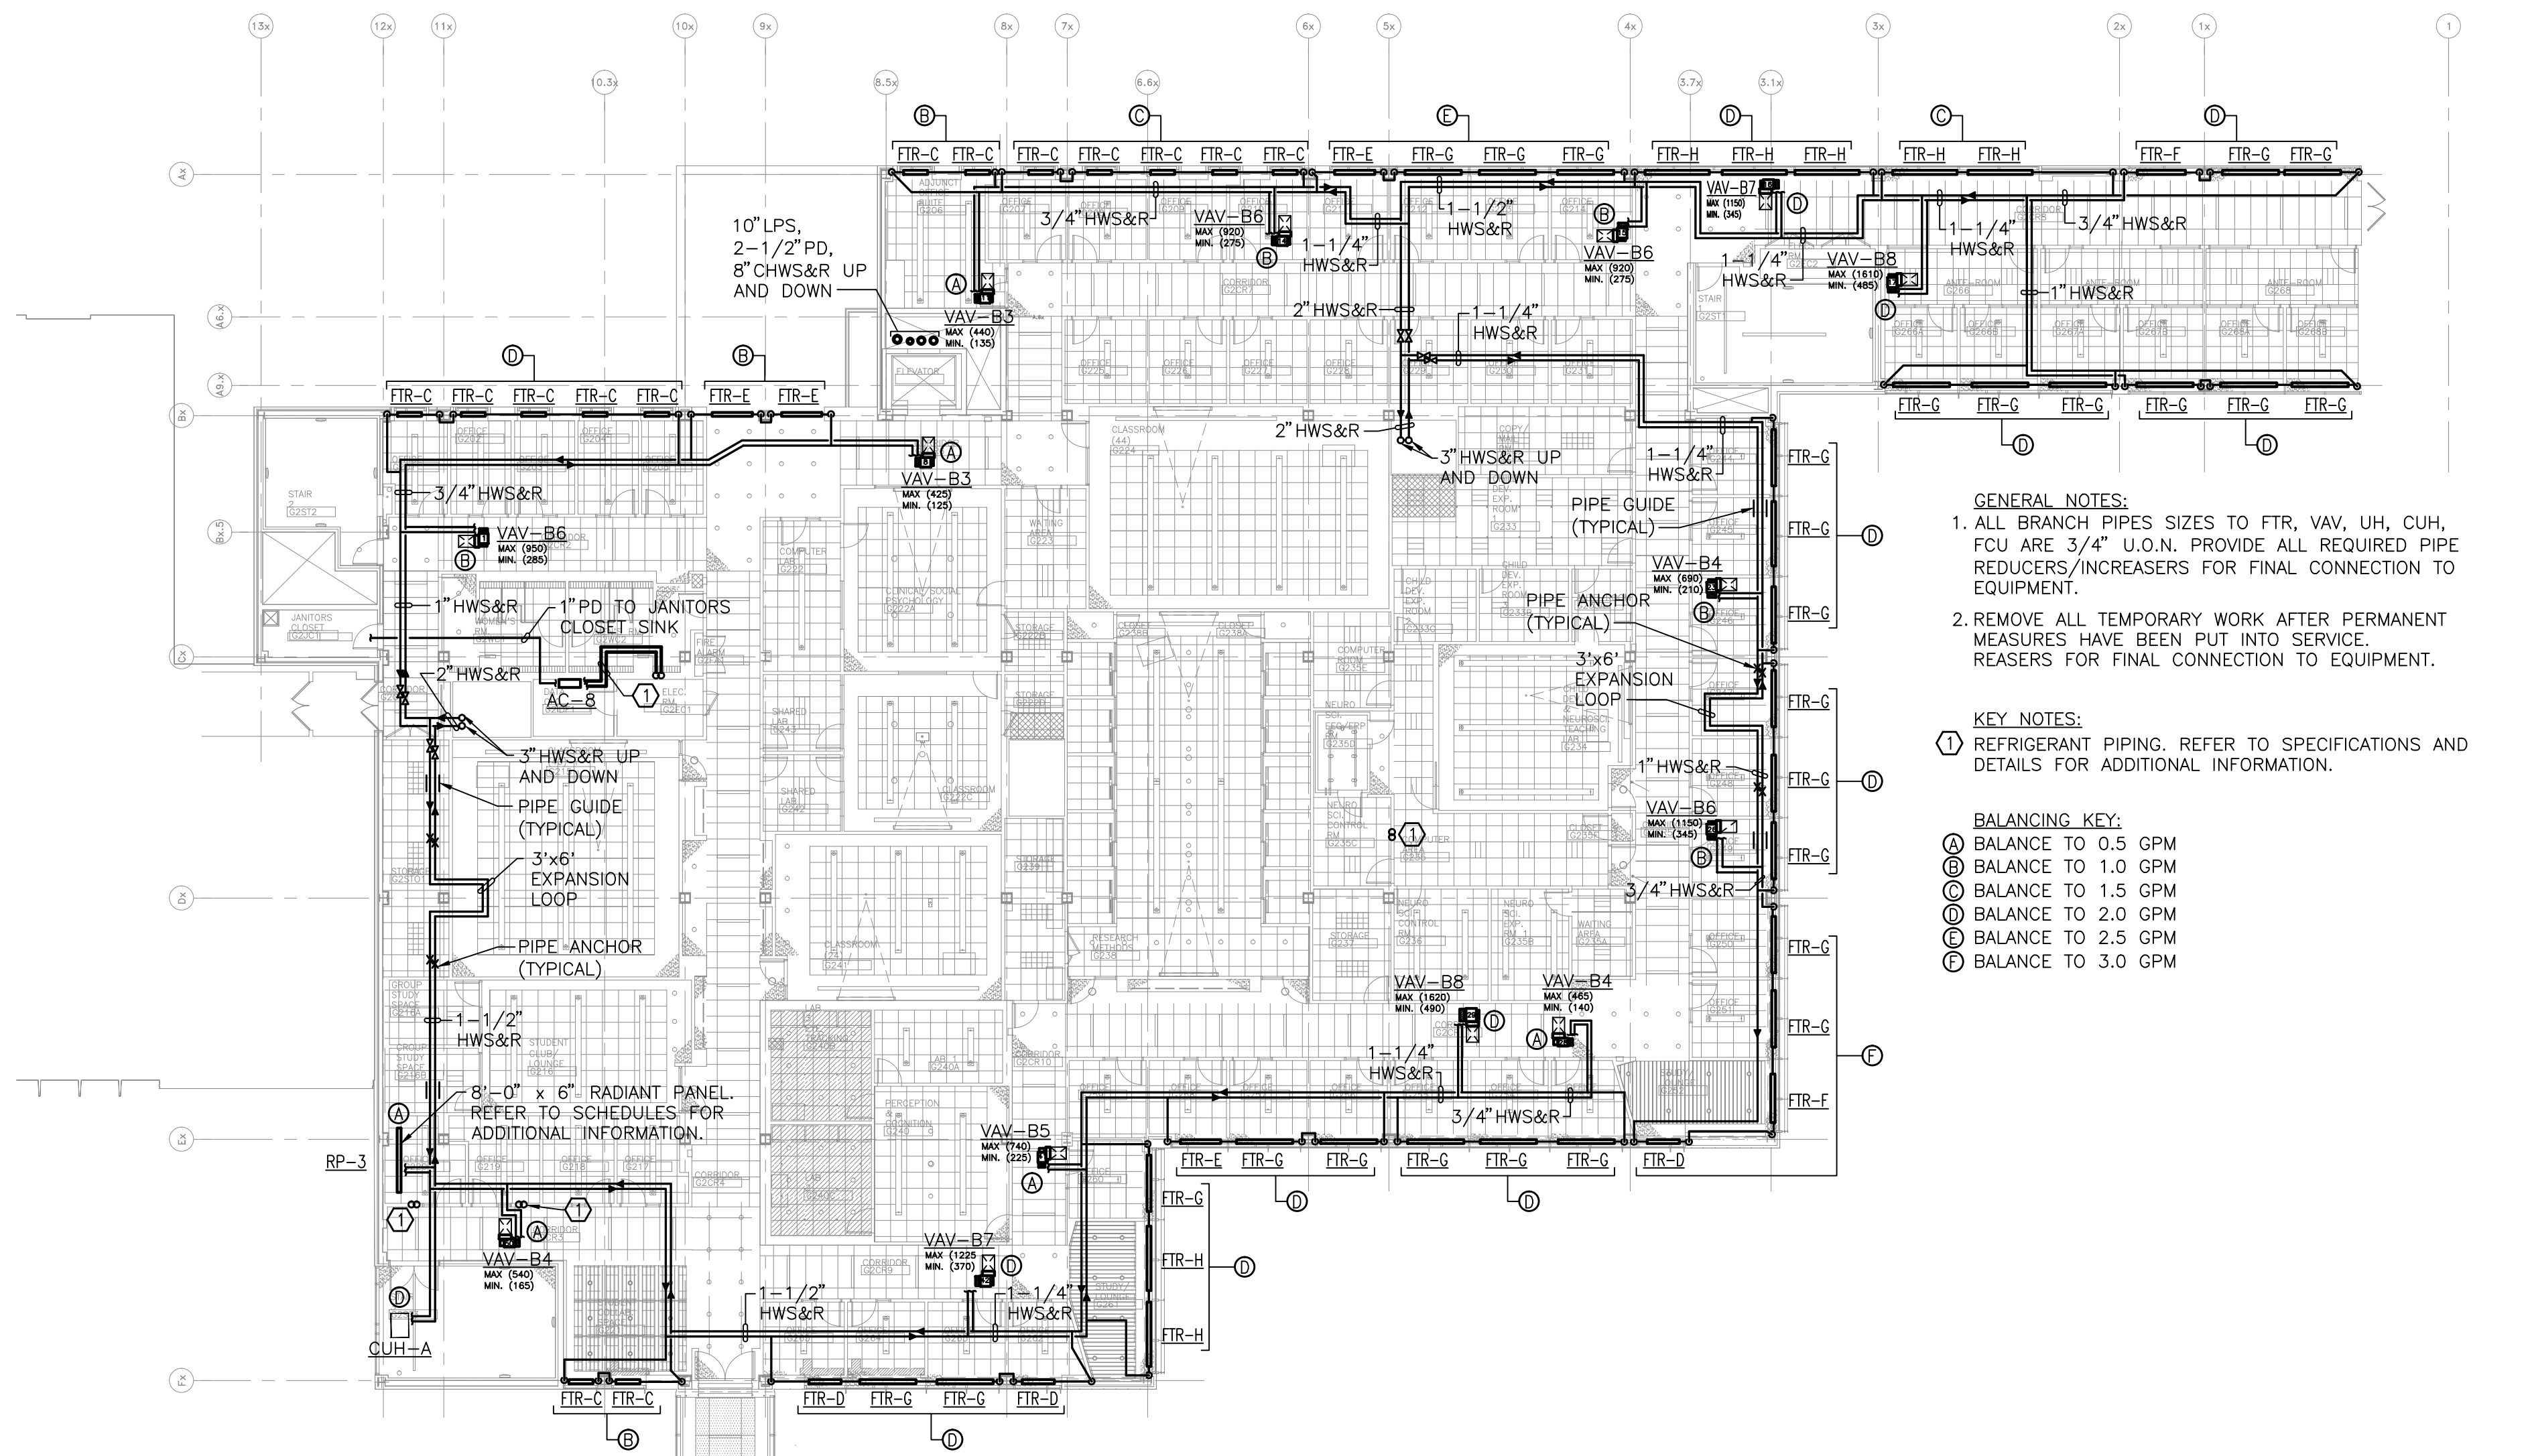

02 SECOND FLOOR PIPING PLAN
SCALE: 1/16\"/>



OWNER:
Ramapo College of New Jersey
505 Ramapo Valley Road
Mahwah, New Jersey 07430-1630

CONSTRUCTION MANAGERS:
Cambridge Construction Management
335 East Main Street
Somerville, NJ 08876
908-253-9500

ARCHITECT:
Mitchell/Giurgola Architects, LLP
200 Ninth Avenue, Suite 711
New York, New York 10003
212 663 4000

MEP ENGINEER:
Joseph R. Loring & Associates, Inc.
619 River Drive Center 1
New York, NY 10001
212 563 7400

STRUCTURAL ENGINEER:
Yisrael A. Seiniuk PC
228 East 45th Street 2nd Floor
New York, NY 10017
212 687 2233

LANDSCAPE ARCHITECT:
Dirtworks, PC
630 Park Avenue South
New York, NY 10003
212 529 2263

SITE CIVIL ENGINEER:
Langan Engineering
619 River Drive Center 1
Elmwood Park, NJ 07407-1338
201 794 6900

AV CONSULTANT:
Cerami & Associates
404 Fifth Avenue
New York, NY 10018
212 370 1776

Key Plan:



6/8/12	DCA FILING
7/19/12	ISSUED FOR BID
7/31/12	DCA RESUBMISSION
9/14/12	BID ADDENDUM #1
1/15/13	ISSUED FOR CONSTRUCTION
9/04/13	BULLETIN #9
8/12/16	AS-BUILT CONSTRUCTION DOCUMENTS
02/17/17	BULLETIN #35 REVISED

NR	DATE	COMMENTS
1	02/17/17	ISSUE/REVISION

ALL DIMENSIONS AND EXISTING CONDITIONS SHALL BE CHECKED AND VERIFIED BY THE CONTRACTOR BEFORE PROCEEDING WITH THE WORK.

Project:
**G-WING RENOVATION &
ADLER CENTER**

Submission:
CONSTRUCTION DOCUMENTS

Drawing Title:
**MECHANICAL
FIRST AND SECOND FLOOR
PIPING PLANS G-WING**

PROJECT NR: 102700 DATE: 6/8/12
RCNJ PROJ. NR: 08-240C SCALE: 1/16\"/>

H3.01G