

OWNER:
Ramapo College of New Jersey
505 Ramapo Valley Road
Mahwah, New Jersey 07430-1630

CONSTRUCTION MANAGERS:
Cambridge Construction Management
335 East Main Street
Somerville, NJ 08876
908-253-9500

ARCHITECT:
Mitchell/Giurgola Architects, LLP
630 Ninth Avenue, Suite 711
New York, New York 10036
212 663 4000

MEP ENGINEER:
Joseph R. Loring & Associates, Inc.
619 Pennsylvania Plaza
New York, NY 10001
212 563 7400


STRUCTURAL ENGINEER:
Yarasi & Senik PC
228 East 45th Street 2nd Floor
New York, NY 10017
212 687 2233

LANDSCAPE ARCHITECT:
Dirtworks, PC
200 Park Avenue South
New York, NY 10003
212 529 2263

SITE CIVIL ENGINEER:
Langan Engineering
619 Park Avenue Center 1
Elmwood Park, NJ 07407-1338
201 794 6900

AV CONSULTANT:
Cerami & Associates
404 Fifth Avenue
New York, NY 10018
212 370 1776

Key Plan:

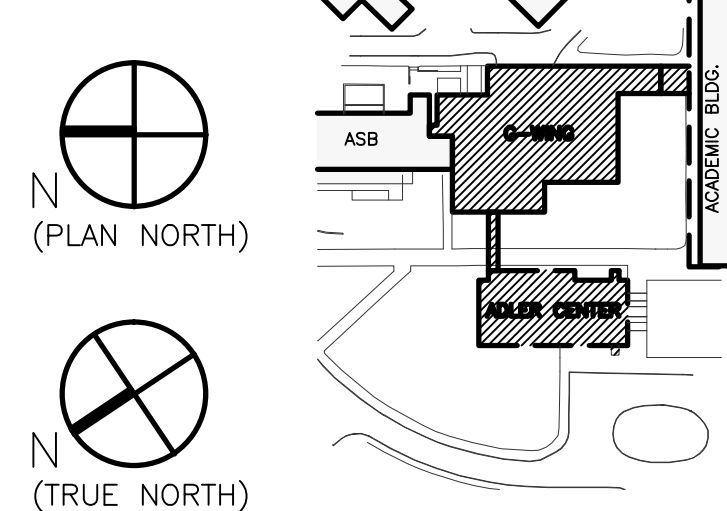

6/8/12	DCA FILING
7/19/12	ISSUED FOR BID
1/15/13	ISSUED FOR CONSTRUCTION
9/10/13	BULLETIN #8
12/12/14	BULLETIN #27
1/20/15	BULLETIN #29
12/07/15	BULLETIN #35
8/12/16	AS-BUILT CONSTRUCTION DOCUMENTS
2/17/17	BULLETIN #35 REVISED
DATE	COMMENTS
ISSUE/REVISION	
ALL DIMENSIONS AND EXISTING CONDITIONS SHALL BE CHECKED AND VERIFIED BY THE CONTRACTOR BEFORE PROCEEDING WITH THE WORK.	

Project:
G-WING RENOVATION & ADLER CENTER

Submission:
CONSTRUCTION DOCUMENTS

Drawing Title:
**ELECTRICAL
1ST FLOOR POWER PLAN
G-WING**

PROJECT NO: 102700 DATE: 6/8/12
RCNJ PROJ. NO: 08-240C SCALE: AS NOTED

E2.01G