



OWNER:
Ramapo College of New Jersey
505 Ramapo Valley Road
Mahwah, New Jersey 07430-1630

CONSTRUCTION MANAGERS:
Cambridge Construction Management
335 East Main Street
Somerville, NJ 08876
908-253-9500

ARCHITECT:
Mitchell/Giurgola Architects, LLP
630 Ninth Avenue, Suite 711
New York, New York 10036
212 529 2263

MEP ENGINEER:
Joseph R. Loring & Associates, Inc.
21 Pennsylvania Plaza
New York, NY 10001
212 794 6900

STRUCTURAL ENGINEER:
Yarael A. Selinuk PC
228 East 45th Street 2nd Floor
New York, NY 10017
212 687 2233

LANDSCAPE ARCHITECT:
Dirtworks, PC
200 Park Avenue South
New York, New York 10003
212 529 2263

SITE CIVIL ENGINEER:
Langan Engineering
619 River Drive Center 1
Elmwood Park, NJ 07407-1338
201 794 6900

AV CONSULTANT:
Cerami & Associates
New York, NY 10018
212 370 1776

Key Plan:



6/8/12	DCA FILING	10/04/13	BULLETIN #11/DCA FILING
7/19/12	ISSUED FOR BID	1/09/14	CONFORMANCE SET
8/17/12	DCA RESUBMISSION	6/2/14	ASI#028
12/10/12	BID ADDENDUM #6	11/25/14	BULLETIN #27
1/15/13	ISSUED FOR CONST.	12/12/15	BULLETIN #35
5/20/13	RFI #056 RESPONSE	8/12/16	AS-BUILT CD'S
7/31/13	ASI #009	2/17/17	BULLETIN #35 (REVISED)
9/16/13	BULLETIN #10		
10/01/13	ASI#014		
NR	DATE	COMMENTS	
ISSUE/REVISION			
ALL DIMENSIONS AND EXISTING CONDITIONS SHALL BE CHECKED AND VERIFIED BY THE CONTRACTOR BEFORE PROCEEDING WITH THE WORK.			


Project:
G-WING RENOVATION & ADLER CENTER

Submission:
CONSTRUCTION DOCUMENTS

Drawing Title:
1ST FLOOR PLAN - G-WING

PROJECT NO: 102700
DATE: 6/8/12
RCH: NR 08-240C
SCALE: SCALE

A2.01G

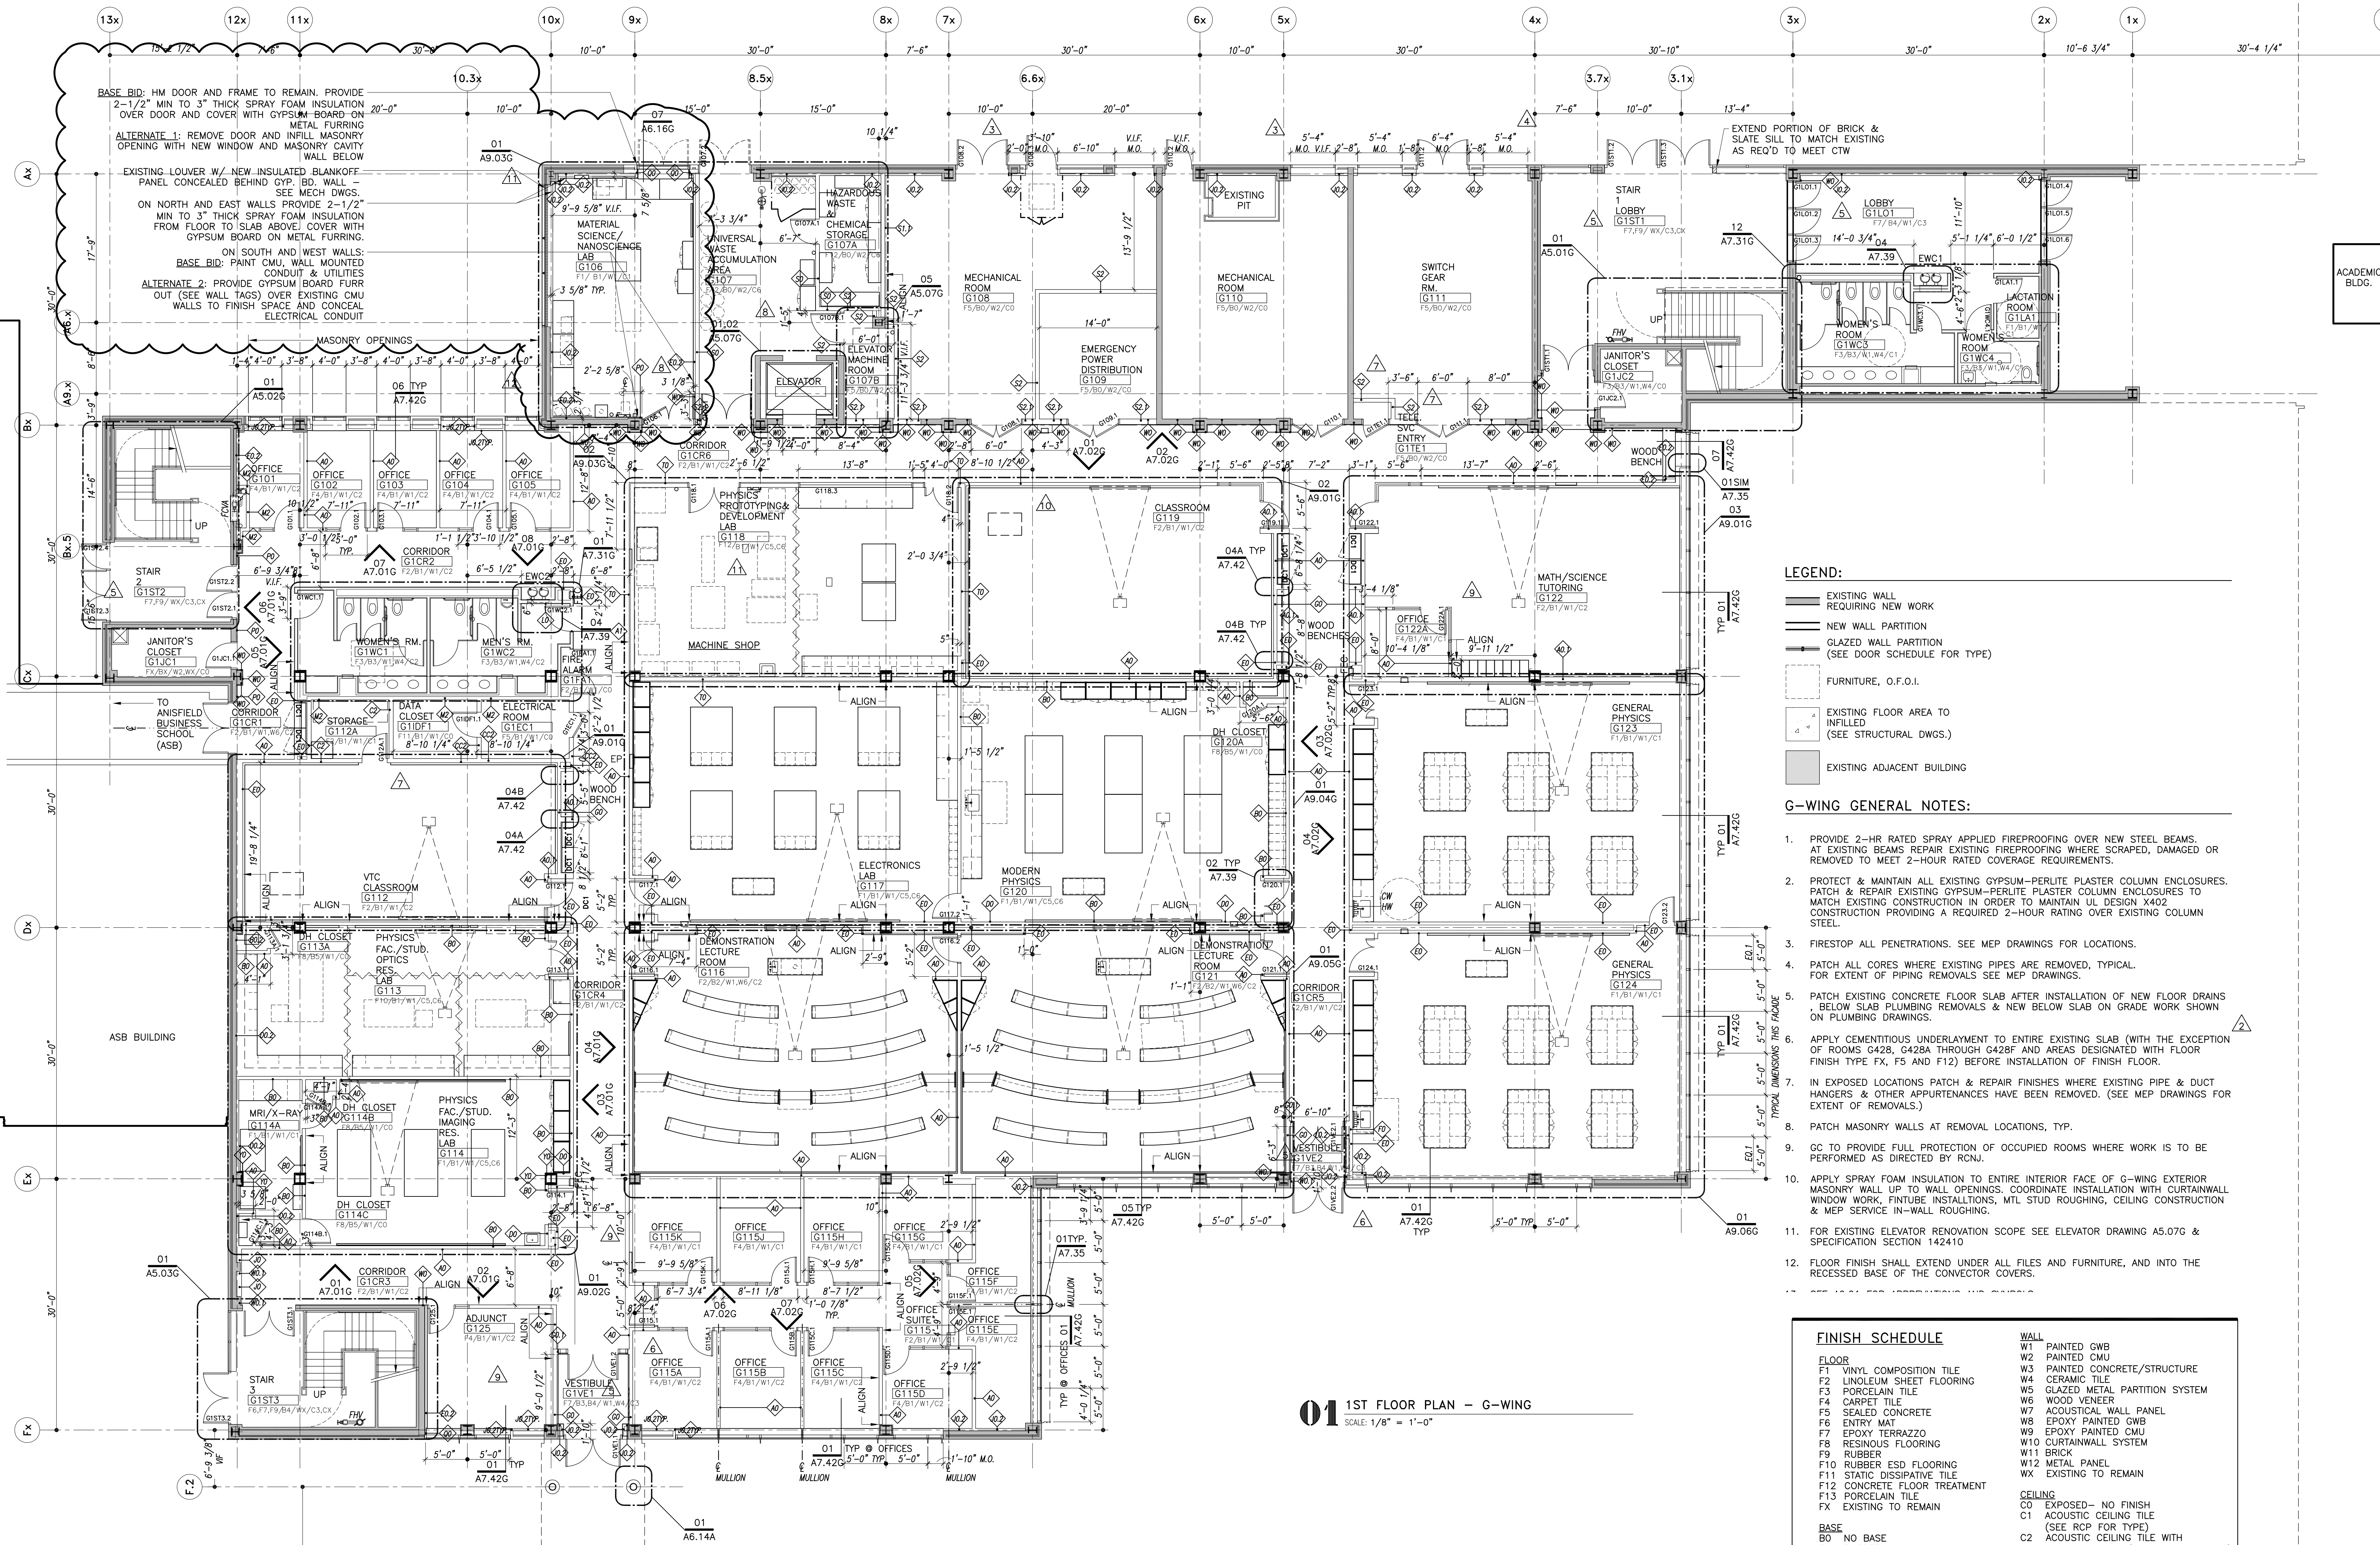

01 1ST FLOOR PLAN - G-WING
SCALE: 1/8" = 1'-0"

LEGEND:

- EXISTING WALL
- REQUIRING NEW WORK
- NEW WALL PARTITION
- GLAZED WALL PARTITION (SEE DOOR SCHEDULE FOR TYPE)
- FURNITURE, O.F.O.I.
- EXISTING FLOOR AREA TO INFILL (SEE STRUCTURAL DWGS.)
- EXISTING ADJACENT BUILDING

G-WING GENERAL NOTES:

- PROVIDE 2-HR RATED SPRAY APPLIED FIREPROOFING OVER NEW STEEL BEAMS. AT EXISTING BEAMS REPAIR EXISTING FIREPROOFING WHERE SCRAPED, DAMAGED OR REMOVED TO MEET 2-HOUR RATED COVER REQUIREMENTS.
- PROTECT & MAINTAIN ALL EXISTING GYPSUM-PERLITE PLASTER COLUMN ENCLOSURES. PATCH & REPAIR EXISTING GYPSUM-PERLITE PLASTER COLUMN ENCLOSURES TO MATCH EXISTING CONSTRUCTION IN ORDER TO MAINTAIN UL DESIGN X402 CONSTRUCTION PROVIDING A REQUIRED 2-HOUR RATING OVER EXISTING COLUMN STEEL.
- FIRESTOP ALL PENETRATIONS. SEE MEP DRAWINGS FOR LOCATIONS.
- PATCH ALL CORES WHERE EXISTING PIPES ARE REMOVED. TYPICAL FOR EXTENT OF PIPING REMOVALS SEE MEP DRAWINGS.
- PATCH EXISTING CONCRETE FLOOR SLAB AFTER INSTALLATION OF NEW FLOOR DRAINS BELOW SLAB PLUMBING REMOVALS & NEW BELOW SLAB ON GRADE WORK SHOWN ON PLUMBING DRAWINGS.
- APPLY CEMENTITIOUS UNDERLAYMENT TO ENTIRE EXISTING SLAB (WITH THE EXCEPTION OF ROOMS G428, G428A THROUGH G428F AND AREAS DESIGNATED WITH FLOOR FINISH TYPE FX, F5 AND F12) BEFORE INSTALLATION OF FINISH FLOOR.
- IN EXPOSED LOCATIONS PATCH & REPAIR FINISHES WHERE EXISTING PIPE & DUCT HANGERS & OTHER APPURTENANCES HAVE BEEN REMOVED. (SEE MEP DRAWINGS FOR EXTENT OF REMOVALS.)
- PATCH MASONRY WALLS AT REMOVAL LOCATIONS, TYP.
- GC TO PROVIDE FULL PROTECTION OF OCCUPIED ROOMS WHERE WORK IS TO BE PERFORMED AS DIRECTED BY RCN.
- APPLY SPRAY FOAM INSULATION TO ENTIRE EXTERIOR FACE OF G-WING EXTERIOR MASONRY WALL UP TO WALL OPENINGS. COORDINATE INSTALLATION WITH CURTAINWALL WINDOW WORK, FINITUBE INSTALLATIONS, MTL STUD ROUGHING, CEILING CONSTRUCTION & MEP SERVICE IN-WALL ROUGHING.
- FOR EXISTING ELEVATOR RENOVATION SCOPE SEE ELEVATOR DRAWING A5.07G & SPECIFICATION SECTION 142410
- FLOOR FINISH SHALL EXTEND UNDER ALL FILES AND FURNITURE, AND INTO THE RECESSED BASE OF THE CONNECTOR COVERS.

FINISH SCHEDULE

FLOOR	WALL
F1 VINYL COMPOSITION TILE	W1 PAINTED GWB
F2 UNOLEUM SHEET FLOORING	W2 PAINTED CMU
F3 PORCELAIN TILE	W3 PAINTED CONCRETE/STRUCTURE
F4 CARPET TILE	W4 CERAMIC TILE
F5 SEALED CONCRETE	W5 GLAZED METAL PARTITION SYSTEM
F6 ENTRY MAT	W6 WOOD VENEER
F7 EPOXY TERRAZZO	W7 ACOUSTICAL WALL PANEL
F8 RESINOUS FLOORING	W8 EPOXY PAINTED GWB
F9 RUBBER	W9 EPOXY PAINTED CMU
F10 RUBBER ESD FLOORING	W10 CURTAINWALL SYSTEM
F11 STATIC DISSIPATIVE TILE	W11 BRICK
F12 CONCRETE FLOOR TREATMENT	W12 METAL PANEL
F13 PORCELAIN TILE	WX EXISTING TO REMAIN
FX EXISTING TO REMAIN	
BASE	CEILING
B0 NO BASE	C0 EXPOSED- NO FINISH
B1 RUBBER	C1 ACOUSTIC CEILING TILE
B2 WOOD	(SEE RCP FOR TYPE)
B3 CERAMIC TILE	C2 ACOUSTIC CEILING TILE WITH
B4 EPOXY TERRAZZO	GWB PERIMETER (SEE RCP FOR TYPE)
B5 INTEGRAL RESINOUS	C3 PAINTED GWB
B6 STAINLESS STEEL	C4 LINEAR WOOD CEILING
B7 QUARRY TILE BASE	C5 T-SLOTTED ALUM. FRAMING SYSTEM
B8 BRICK	C6 PAINT EXIST. DECK, EXPOSED MEP,F,T
BX EXISTING TO REMAIN	WORK & NEW GYF. BD. BOX BEAMS
	AROUND EXISTING/NEW FIREPROOFED
	BEAMS
	C7 ACOUSTICALLY TRANSPARENT CEILING
	SYSTEM
	CX PAINT EXISTING TO REMAIN