


LIGHTING FIXTURE SCHEDULE						
SYMBOL	TYPE	DESCRIPTION	MANUFACTURER/No.	LAMP/TYP	VOLT	REMARKS
•	S	6.5" SEMI RECESS DECORATIVE LIGHT FIXTURE	LOUIS POULSEN BALLERUP 6.5" BAL-1/18W/CF GX24q-2-277-WHT	(1) 18W CF 3000K	277V	EQUAL: WILA LIGHTING 110 02/277-WH-ZSH5-EB-X
•	Sd	6.5" SEMI RECESS DIMMABLE DECORATIVE LIGHT FIXTURE	LOUIS POULSEN BALLERUP 6.5" BAL-1/18W/CF GX24q-2-277-WHT-LUTRON DIMMING	(1) 18W CF 3000K	277V	EQUAL: WILA LIGHTING 110 02/277-WH-ZSH5-DIM-X
	T	NOT USED				
=====	U	PENDANT MOUNTED CONTINUOUS LINEAR T5 FLUORESCENT DIRECT/INDIRECT FIXTURE. MOUNTED ON AIRCRAFT CABLE. LENGTHS VARY SEE RCP FOR CONTINUOUS RUNS	LITECONTROL LATITUDE L P-ID-82M-2-VARIES-T5-BW- CWM-LP/ELB-1CWQ-ECS	(2) 28W T5 3000K	277V	U1 = 4' LENGTH U2 = 8' LENGTH U3 = 12' LENGTH U4 = 16' LENGTH U5 = 20' LENGTH U6 = 24' LENGTH U7 = 28' LENGTH
-----	Vd	DIMMABLE WALL MOUNTED SCONCE	MARK ARCHITECTURAL LIGHTING ECLIPSE WALL SERIES ECW-1-T5HO-EDE10-277	(1) 54W T5HO 3000K	277V	V1d = 4' LENGTH V2d = 24' LENGTH DIMMING BALLAST
□	W	PENDANT SOLID STATE LED LIGHT FIXTURE WITH INTEGRAL ELECTRONIC HPF CONSTANT CURRENT DRIVER ANODIZED ALUM OPTICAL HOUSING/HEAT SINK, SILVER PAINTED TRIM. PROVIDE WALLWASH PENDANT MOUNT.	ELLIPTIPAR, S105-0350-X-00-2-SV-0-30-00 MOUNT: VPL-07-X-0	3000K, 84+ CRI LED POWER INPUT: 8W	277V	
□	Wd	DIMMABLE PENDANT SOLID STATE LED LIGHT FIXTURE WITH INTEGRAL ELECTRONIC HPF CONSTANT CURRENT DRIVER ANODIZED ALUM OPTICAL HOUSING/HEAT SINK, SILVER PAINTED TRIM. PROVIDE WALLWASH PENDANT MOUNT.	ELLIPTIPAR, S105-0700-X-00-V-SV-0-30-00 MOUNT: VPL-07-X-0	3000K, 84+ CRI LED POWER INPUT: 18W	277V	DIMMING LED DRIVER, COORDINATE DIMMING CONTROL.
⦿	X	EDGE LIT EXIT SIGN, POLISHED ACRYLIC PANEL, FULLY ILLUMINATED INCISED OUTLINE, CAST ALUMINUM SATIN FINISHED HOUSING, WALL RECESSED INSTALLATION, PROVIDE DIRECTIONAL ARROWS AS INDICATED ON FLOOR PLANS	McPHILBEN ER45VXL-W-1-RC-X	LED LIGHT SOURCE	277V	
○	Y	PENDANT COMPACT FLUORESCENT LIGHT FIXTURE WITH WHITE FINISH, GLASS REFLECTOR, WIRE GUARD.	HOLOPHANE PGI-42CFL-27-86-W-X-ELB-0256	(1) 42W CFL 3000K	277V	
=====	Z	PENDANT MOUNTED CONTINUOUS LINEAR FLUORESCENT DIRECT/INDIRECT FIXTURE. MOUNTED ON AIRCRAFT CABLE.	MATCH STANDARD FIXTURE TYPE AT ASB WING		277V	FOR PRICING PURPOSE USE TYPE B LIGHT FIXTURES IN LENGTH INDICATED
○	SL1	RECESSED DIMMABLE LED 4.5" DIAMETER STEP LIGHT. PROVIDE 120V INTEGRAL DIMMING DRIVER.	COLE LIGHTING 56/L287-DIM	3000K NEUTRAL WHITE LEDs INPUT WATTS: 5W	120V	FIXTURE INSTALLATION TO BE COORDINATED WITH G116 & G121 ARCH. WOODWORK CONTRACTOR.
○	AA	RECESSED 6" ROUND APERTURE COMPACT FLUORESCENT OPEN DOWNLIGHT, WHITE FINISH	ZUMTOBEL SPEC 5 S5D6313H-U-6313HR-MC-W-WRL	CF26DT/830/ ECO INPUT: 32W	277V	ADLER CENTER, MULTIPLE LOCATIONS. WATTAGE RESTRICTION LABEL FOR 26W LAMP
○	AA1	RECESSED 6" ROUND APERTURE COMPACT FLUORESCENT OPEN WALLWASHER	ZUMTOBEL SPEC 5 S5D6313H-U-6313HW-MC-W-WRL	CF26DT/830/ ECO INPUT: 32W	277V	ADLER CENTER, MULTIPLE LOCATIONS. WATTAGE RESTRICTION LABEL FOR 26W LAMP
○	AA2	RECESSED 6" ROUND APERTURE COMPACT FLUORESCENT OPEN CORNER WALLWASHER	ZUMTOBEL SPEC 5 S5D6313H-U-6313HK-MC-W-WRL	CF26DT/830/ ECO INPUT: 32W	277V	ADLER CENTER, MULTIPLE LOCATIONS. WATTAGE RESTRICTION LABEL FOR 26W LAMP
=====	BB	RECESSED 5" WIDE LENSED T5 FLUORESCENT LINEAR WALLGRAZER	MARK LIGHTING SP SERIES SPR-(LENGTH)-FL-1/T5S-EBPR- 277-SW	FP28/830/ECO 8.5W/LF	277V	ADLER CENTER, MULTIPLE LOCATIONS. CONTRACTOR TO COORDINATE CEILING TYPE & FIXTURE RUN LENGTH - SEE ARCHITECTURAL DRAWINGS
=====	BB1	RECESSED 5" WIDE DIMMABLE LENSED T5 FLUORESCENT LINEAR WALLGRAZER. DIMMING PROTOCOL: 3-WIRE CONTROL (H, DH, N)	MARK LIGHTING SP SERIES SPR-(LENGTH)-FL-1/T5S-EDES-(3-WIRE H, DH, N)-277-SW	FP28/830/ECO 8.5W/LF	277V	ADLER CENTER, MULTIPLE LOCATIONS. LUTRON ECOSYSTEM WITH 3-WIRE FLUORESCENT CONTROL; CONTRACTOR TO COORDINATE CEILING TYPE & FIXTURE RUN LENGTH - SEE ARCHITECTURAL DRAWINGS
•	CC	CABLE MOUNTED DIMMABLE 4" DIAMETER X 2' LONG LED ACRYLIC CYLINDER, TANDEM-MOUNTED IN SETS OF TWO. (2) 2' LONG 4" DIA. BODY; REMOTE DIMMING DRIVER REQUIRED - CONTRACTOR TO COORDINATE LOCATION (MAXIMUM REMOTE DISTANCE FROM DRIVER TO BOTTOM OF FIXTURE IS 200' WITH 12 GAUGE FEED PER MANUFACTURER); CONTRACTOR TO COORDINATE FIXTURE OVERALL HEIGHT (OAH) - SEE ARCHITECTURAL DRAWINGS	VISA LIGHTING SEQUENCE TANDEM CP5203-2"-4" -LEDWHT-3000K-RMB WHITE-DIM10-OAH(VARIES)	3000K NEUTRAL WHITE LED 900 LUMENS INPUT: 36.4W	277V	ADLER CENTER LOBBY STAIR OPENING MOUNTED TO 1ST FLOOR CEILING, SEE DESCRIPTION NOTES PROVIDE REMOTE 0-10V DIMMING DRIVER.
=====	DD	RECESSED 4" LONG DIMMABLE LINEAR FLUORESCENT DROP-LENSED FIXTURE, 2" LENS DROP FROM CEILING LINE TO BOTTOM OF LENS; ECOSYSTEM DIMMING BALLAST WITH 3-WIRE (H,N,DH) CONTROL. CONTRACTOR TO COORDINATE FIXTURE MOUNTING W/CEILING TYPE	3G LINEAR KUBO 3G-RJL-4FT-1T5-(VOLTAGE)-DECO-X-X- DD/2"-WH	FP28/830/ECO INPUT: 32W 3-WIRE DIMM. CONTROL.	277V	ADLER CENTER 2ND FLOOR CONFERENCE & RESEARCH ROOM. SEE DESCRIPTION NOTES
○	EE	SURFACE MOUNTED 24" DIAMETER ADJUSTABLE LED FLOODLIGHT MOUNTED TO TERRACE CANOPY STRUCTURE. PROVIDE EXTRA MFL LENS FOR FIELD ADJUST; ARCHITECT TO SELECT FINISH. CONTRACTOR TO COORDINATE LOCATION OF REMOTE POWER SUPPLY & MOUNTING DETAILS.	B-K NITE STAR NS-LED-E22-WFL & EXTRA MFL-AQ-CUSTOM COLOR-12-11- (CANOPY)-(REMOTE POWER SUPPLY)	3000K NEUTRAL WHITE INPUT: 8.4W POWER SUPPLY	277V	ADLER CENTER 2ND FLOOR TERRACE CANOPY. SEE DESCRIPTION NOTES
•	FF	RECESSED 2" ROUND APERTURE LED WET LOCATION ADJUSTABLE ACCENT LIGHT. ARCHITECT TO SELECT FINISH. CONTRACTOR TO COORDINATE MOUNTING	LUCIFER LIGHTING, FIXTURE: DL222P-NC- (CUSTOM FINISH)-(CEILING THICKNESS) -8013-30-2, HOUSING: DH-NC-2F- (CEILING THICKNESS)-8013-UNWIND	3000 WHITE LED INPUT WATTS: 27W	277V	ADLER CENTER GROUND & 1ST FLOOR VESTIBULE CANOPIES
•	GG	RECESSED 4" APERTURE COMPACT FLUORESCENT LENSED COUNTER DOWNLIGHT. CUSTOM FINISH TO BE SELECTED BY ARCHITECT	ZUMTOBEL BRADHCF1-18W-U BRADHCF1-18W-GX24Q2-CS-C-CA	CF18DT/830/ ECO INPUT WATTS: 19W	277V	ADLER CENTER CAFE
■	HH	SURFACE MOUNTED ADJUSTABLE LED CANOPY UPLIGHT	ERCO 34091.023-(CUSTOM COLOR, RAL COLOR TO BE SELECTED BY ARCHITECT)	3000K WARM WHITE LED 1305 LUMENS INPUT: 20W	277V	ADLER CENTER SOUTH FACADE, FLOOD BEAM, CONTRACTOR TO COORDINATE MOUNTING DETAILS & WIRING W/ ARCH. DETAILS
■	HH1	SURFACE MOUNTED DIMMABLE ADJUSTABLE LED STAIR DOWNLIGHT	ERCO 34035.023-(CUSTOM COLOR, RAL COLOR TO BE SELECTED BY ARCHITECT)	3000K WARM WHITE LED 870 LUMENS INPUT: 13W	277V	ADLER CENTER SOUTH FACADE, OVAL FLOOD BEAM, CONTRACTOR TO COORD. MOUNTING DETAILS & WIRING W/ ARCH. DETAILS
■	HH2	SURFACE MOUNTED ADJUSTABLE LED CANOPY UPLIGHT	ERCO 34095.023-(CUSTOM COLOR, RAL COLOR TO BE SELECTED BY ARCHITECT)	3000K WARM WHITE LED 1305 LUMENS INPUT: 20W	277V	ADLER CENTER TERRACE, OVAL FLOOD BEAM, CONTRACTOR TO COORDINATE MOUNTING DETAILS & WIRING W/ ARCH. DETAILS
-----	JJ	SURFACE MOUNTED STAGGERED T5 LENSED FLUORESCENT COVE LIGHT	ZUMTOBEL SLSI-1285-(LENGTH)-U-SM	FP28/830/ECO 8.5W/LF	277V	ARCHITECTURAL COVE AT INTERIOR STAIR EDGE. CONTRACTOR TO COORDINATE FIXTURE RUN LENGTHS & MOUNTING W/ ARCH. DETAILS
⦿	KK	RELOCATED EXISTING EXTERIOR POLE MOUNTED METAL HALIDE LIGHT FIXTURE. COLOR: DARK BRONZE	(EXISTING FIXTURES) KIM LIGHTING IASAR2 175MH DB POLE: HAPCO 11-083 IN DB	175W METAL HALIDE	277V	PROTECT (2) EXISTING LIGHT FIXTURES & REINSTALL IN NEW LOCATION PER LANDSCAPE & ELECTRICAL DWGS.
•	LL	EXTERIOR HORIZONTAL LOUVER BOLLARD W/ SYMMETRICAL 360° LIGHT DISTRIBUTION, FULLY GASKETED FOR WEATHER TIGHT OPERATION. SUITABLE FOR WET LOCATIONS. 3-PLY OPAL DIFFUSER. COLOR: TBD	BEGA 8429P	(1) 13W CF G24Q-1	277V	SITE BOLLARD
□	MM	EXTERIOR WALL MOUNTED COMPACT FLUORESCENT LIGHT FIXTURE CUSTOM COLOR: TO BE SELECTED BY ARCHITECT	BEGA 2483-X-32W WITH BEGA # 76390 BALLAST (OSRAM S1853 BALLAST)	(1) 32W TRIPLE TUBE CF	277V	-5 F/-20C STARTING TEMPERATURE WITH OSRAM S1853 BALLAST
○	NN	EXTERIOR RECESSED MOUNTED METAL HALIDE LIGHT FIXTURE	BEGA 6942MH.564MH	(1) 100W PAR 38 MH	277V	ADLER/G-WING BRIDGE SOFFIT & G-WING/ACADEMIC BLDG LINK SOFFIT
I	LIU-1	EXTRUDED ALUMINUM, RECESSED, FLUORESCENT LASER IN USE SIGN IN STAINLESS STEEL SATIN FINISH.	COLE LIGHTING S252-F-277-N-"LASER IN USE" COPY	(1) 7W CF	277V	
I	IU-1	EXTRUDED ALUMINUM, RECESSED, FLUORESCENT IN USE SIGN IN STAINLESS STEEL SATIN FINISH.	COLE LIGHTING S252-F-277-N-"IN USE" COPY	(1) 7W CF	277V	
□	TT	EXTERIOR WALL MOUNTED COMPACT FLUORESCENT LIGHT WEATHER TIGHT GASKETED FIXTURE, CANOPY TO BE INSTALLED ROTATED 15 DEGREES UPWARD. FINISH: MANUFACTURER'S STANDARD BRONZE.	BEGA 06890 P-BRZ-42W-277V-X	(1) 42W CF	277V	STANDARD -5F/-20C STARTING TEMPERATURE BALLAST

LIGHTING FIXTURE SCHEDULE						
SYMBOL	TYPE	DESCRIPTION	MANUFACTURER/No.	LAMP/TYP	VOLT	REMARKS
A		RECESSED LINEAR FLUORESCENT FIXTURE W/ SOFT GLOW LENS WHITE SIDES & ENDS. TANDEM WIRING AND ELECTRONIC BALLAST. SEE ARCHITECTURAL DRAWINGS FOR CONT. FIXTURE LENGTHS.	LITECONTROL MOD NG-D-44TZ14T5-SGL-CWT-IND-LP/ELB- -TW-TEG-277	(2) 28W-T5 3000K	277V	A1 = 4' LENGTH A2 = 8' LENGTH A3 = 12' LENGTH A4 = 16' LENGTH A5 = 20' LENGTH A6 = 24' LENGTH A7 = 28' LENGTH
A8		RECESSED LINEAR FLUORESCENT FIXTURE W/ SOFT GLOW LENS WHITE SIDES & ENDS. TANDEM WIRING AND ELECTRONIC BALLAST. SEE ARCHITECTURAL DRAWINGS FOR CONT. FIXTURE LENGTHS.	LITECONTROL MOD TECHZONE 4" NG-D-44TZ21T5-SGL-CWT-IND-LP/ELB- -TW-TEG-277	(2) 28W-T5 3000K	277V	A8 = 5' LENGTH
=====	B_	PENDANT MOUNTED CONTINUOUS LINEAR T5 FLUORESCENT INDIRECT FIXTURE. MOUNTED ON AIRCRAFT CABLES. (2) LAMP CROSS SECTION, TANDEM WIRING. LENGTHS VARY SEE RCP FOR CONTINUOUS RUNS	LITECONTROL ARCOS PERF II T5 INDIRECT P-I-59-24T5-TCWM-LP/ELB-TW-2CQW- ECSS-277	(2) 28W-T5 3000K	277V	B1 = 4' LENGTH B2 = 8' LENGTH B3 = 12' LENGTH B4 = 16' LENGTH B5 = 20' LENGTH B6 = 24' LENGTH B7 = 28' LENGTH B8 = 32' LENGTH
=====	B_d	PENDANT MOUNTED DIMMABLE CONTINUOUS LINEAR T5 FLUORESCENT INDIRECT FIXTURE. MOUNTED ON AIRCRAFT CABLES. LENGTHS VARY. (2) LAMP CROSS SECTION SEE RCP FOR CONTINUOUS RUNS	LITECONTROL ARCOS PERF II T5 INDIRECT P-I-59-48T5-TCWM-LP/DIO-1CWQ- ECSS-277	(2) 28W-T5 3000K	277V	B1d = 4' LENGTH B3d = 12' LENGTH B4d = 16' LENGTH
=====	B_h	PENDANT MOUNTED CONTINUOUS LINEAR T5 FLUORESCENT INDIRECT FIXTURE. (2) LAMP CROSS SECTION. MOUNTED ON AIRCRAFT CABLES. LENGTHS VARY SEE RCP FOR CONTINUOUS RUNS	LITECONTROL ARCOS PERF II T5 INDIRECT P-I-59-24T5HO-TCWM-LP/ELB- 1CWQ-ECSS-277	(2) 54W-T5 3000K	277V	B1h = 4' LENGTH B2h = 8' LENGTH
=====	C	LINEAR FLUORESCENT FIXTURE RECESSED IN ACOUSTIC TILE CEILING. EXTRA DIFFUSE LENS, WHITE FINISH	LITECONTROL MOD TECHZONE 4" NG-D-44TZ14T5-SGL-CWT-IND-LP/ELB- X-TEG-277	(1) 28W-T5 3000K	277V	
=====	D	RECESSED, LINEAR FLANGELESS FLUORESCENT WALLWASHER W/ PLASTER EDGE TRIM FOR GYPSUM BOARD CEILINGS (SEE RCP FOR CONTINUOUS RUNS)	LITECONTROL MOD TECHZONE 4" RP-WWD-44-14T5-SGL-CWM-LP/ELB- X-277	28W-T5 3000K	277V	D1 = 4' LENGTH D2 = 8' LENGTH D3 = 12' LENGTH D4 = 16' LENGTH D5 = 20' LENGTH D6 = 24' LENGTH D7 = 28' LENGTH
=====	D_-A	RECESSED, LINEAR FLANGELESS FLUORESCENT WALLWASHER FOR INSTALLATION IN ACOUSTICAL CEILING TILE 9/16" GRID. BOTTOM OF FIXTURE TO ALIGN WITH ADJACENT BOTTOM OF REGULAR CEILING TILE. (SEE RCP FOR CONTINUOUS RUNS)	LITECONTROL MOD TECHZONE 4" LG-WWD-44-14T5-SGL-CWM-LP/ELB- X-277-TEG	28W-T5 3000K	277V	D1-A = 4' LENGTH D2-A = 8' LENGTH D3-A = 12' LENGTH D4-A = 16' LENGTH D5-A = 20' LENGTH D6-A = 24' LENGTH D7-A = 28' LENGTH
○	E	6" DIA RECESSED FLUORESCENT DOWNLIGHT W/ TRIPLE TUBE HORIZONTAL LAMP DIFFUSE REFLECTOR, WHITE FLANGE TRIM & ELECTRONIC BALLAST	LIGHTOLIER #8031CCDW (REFLECTOR) #56132BU (FRAME-IN-KIT)	(1) 32W TRIPLE TUBE CFL (3000K)	277V	EQUAL: GOTHAM AF 1/32TRT 6WR LD MOVLT-TRW
○	Ed	6" DIA RECESSED FLUORESCENT DOWNLIGHT W/ TRIPLE TUBE HORIZONTAL LAMP DIFFUSE REFLECTOR, WHITE FLANGE TRIM & DIMMING BALLAST	LIGHTOLIER #8031CCDW (REFLECTOR) #56132B-J2LD3 (FRAME-IN-KIT)	(1) 32W TRIPLE TUBE CFL (3000K)	277V	DIMMING BALLAST EQUAL: GOTHAM AF 1/32TRT 6WR LD MOVLT-DIMMING BALLAST-TRW
=====	F	RECESSED LINEAR FLUORESCENT FIXTURE W/ SPECULAR LOUVERS, WHITE SIDES & ENDS. ELECTRONIC BALLAST. SEE ARCHITECTURAL DRAWINGS FOR CONT. FIXTURE LENGTHS. SWITCH CONTROL INDICATED BY LAMP SEGMENT	ZUMTOBEL STAFF RECESSED BIVERGENCE RBU-C-VARIES-2285-U	(2) 28W-T5 3000K	277V	F1 = 5' LENGTH F2 = 4' LENGTH
=====	G	DIRECT/INDIRECT RECESSED FLUORESCENT LAY-IN FIXTURE. PERFORMED MESH SIDE BASKETS W/ WHITE ACRYLIC OVERLAY G2d = SAME AS ABOVE BUT DIMMABLE	LITECONTROL LITEWAVE NG-D-LRS-2-VARIES-2-T5-PFO- CWM-LP/ELB	(2) 28W-T5 3000K	277V	G1 = 2'X2' G2 = 2'X4' G2d = 2'X4' W/ DIMMING BALLAST
=====	H	LINEAR FLUORESCENT FIXTURE RECESSED IN GYPSUM BOARD CEILING. STAGGERED LAMPING, EXTRA DIFFUSE LENS, WHITE FINISH SEE RCP FOR CONTINUOUS RUNS	SE'LUX M60 SERIES M6R15-1T5-0D-VARIES-WH	(1) 28W-T5 3000K	277V	H1 = 8' LENGTH H2 = 12' LENGTH H3 = 16' LENGTH H4 = 16' LENGTH H5 = 20' LENGTH
=====	I	SURFACE MOUNTED LINEAR LED DISPLAY CASE LIGHT. PROVIDE BRITELINE LED PRODUCT WITH gLINE EXTRUSION; PROVIDE CUSTOM BLACK FINISH AND STANDARD LENS; PROVIDE REMOTE POWER SUPPLIES-CONTRACTOR TO COORDINATE ALL JUMPS, CONNECTORS, ETC. TO COMPRISE COMPLETE SYSTEM; CONTRACTOR TO SPECIFY WIRE FEED TYPE; CONTRACTOR TO PROVIDE RUN LENGTHS TO MANUFACTURER; MANUFACTURER TO PROVIDE SHOP DRAWINGS SHOWING ALL LENGTHS FOR APPROVAL	OPTOLUM BLG-3500K-JC-SL-(WIRE FEED)-02-40-(length) POWER SUPPLY: P596-277	3000K NEUTRAL WHITE LEDs INPUT WATTS: 7.2W/LF	277V	SEE DESCRIPTION NOTES
=====	J	ENCLOSED GASKETED FLUORESCENT LAY-IN LIGHT FIXTURE DESIGNED FOR WET ENVIRONMENTS. STAINLESS STEEL HOUSING AND PRISMATIC POLYCARBONATE LENS.	PARAMOUNT G2-4-28T5-B-S2 1" T-BAR	(4) 28W-T5 3000K	277V	J1 = 2'X2' J2 = 2'X4'
=====	J_f	ENCLOSED GASKETED FLUORESCENT LAY-IN LIGHT FIXTURE DESIGNED FOR FOOD SERVICE ENVIRONMENTS. STAINLESS STEEL HOUSING AND PRISMATIC POLYCARBONATE LENS. PROVIDE "FOODZONE LENS FRAME" AT CAFE SERVICE & CAFE STORAGE	PARAMOUNT F02-4-4-28T5-B-S2 1" T-BAR ELECTRONIC BALLAST	(4) 28W-T5 3000K	277V	J1f = 2'X2'
=====	K	CONTINUOUS RECESSED FLUORESCENT PERIMETER FIXTURE. STAGGERED LAMPING, WHITE BAFFLES, WHITE FINISH	MARK ARCHITECTURAL LIGHTING MP-VERIFY LENGTHS-1T5S-EBPR- 277-PB2	(1) 28W-T5 3000K	277V	
=====	L	RECESSED FLUORESCENT PARABOLIC LIGHT FIXTURE WITH RAPID START ELECTRONIC BALLAST.	LITHONIA PM3 2'X2' 2PM3-B-B-2-U31-9-LD	(2) 31W-T8 3000K	277V	L1 = 2'X2'
=====	M	LOW PROFILE WALL MOUNTED FLUORESCENT TASKLIGHT FIXTURE. SATIN ALUMINUM FINISH WITH MATCHING END CAPS ONLY AT ENDS OF CONTINUOUS RUNS. OPAL PRISMATIC LENS, ROCKER SWITCH AND ELECTRONIC BALLAST. SEE RCP FOR CONTINUOUS RUNS FOR ARCHITECTURAL INTERIOR ELEVATIONS FOR CONTINUOUS HOUSING LENGTHS.	BARTCO BFL293 BFL293-14-277-SA-RS-LNS930- EC931 BARTCO BFL293 BFL293-21-277-SA-RS-LNS930- EC931 BARTCO BFL293 BFL293-28-277-SA-RS-LNS930- EC931	(1) 14W-T5 3000K (1) 14W-T5 3000K (1) 28W-T5 3000K	277V 277V 277V	M1 = 30" LENGTH M2 = 36" LENGTH M3 = 42" LENGTH M4 = 48" LENGTH
I	N	15" DIAMETER FLUORESCENT WALL-MOUNTED SCONCE FIXTURE. POLISHED ALUMINUM FINISH, OPALINE POLYCARBONATE LENS AND ELECTRONIC BALLAST.	LUCE PLAN METROPOLI D20	(2) 26W-FSQ 3000K	277V	
=====	O	4' FLUORESCENT INDUSTRIAL OPEN LAMP FIXTURE WITH WIRE GUARD. MOUNTED ON STEMS, LENGTHS VARY. WHITE HOUSING FINISH.	MERCURY LIGHTING MIE6 SERIES WG-MIE6-2-28-T5-ELB	(2) 28W-T5 3000K	277V	
○	P	6.3" DIAMETER SEMI-RECESSED DOWNLIGHT FIXTURE. ALUMINUM HOUSING WITH METALIZED CHROME FINISH, WHITE OPAL GLASS DIFFUSER	LOUIS POULSEN MUNKEGAARD 6.3" MUNK-6.3	(1) 13W CF GX24Q-1 3000K	277V	ELECTRONIC BALLAST EQUAL: WILA LIGHTING 126 01/277-WH-DFS-EB-TRW
○	Q	INDUSTRIAL DOWNLIGHT WITH ACCENT UP LIGHT. ALUMINUM HOUSING WITH UPLIGHT SHIELD. PIPE MOUNTED.	DELRAY LIGHTING 7600-1-32-2-CM1	(1) 32W G24Q-3 3000K	277V	
○	R	12" DIAMETER RECESSED CONCAVE DOME LIGHT FIXTURE. WHITE HOUSING, WHITE ACRYLIC DOME	MARK ARCHITECTURAL LIGHTING MAGELLAN SERIES MG-1-1-32CFL-EBPR-277	(1) 32W CFL 3000K	277V	



OWNER:  
Ramapo College of New Jersey  
505 Ramapo Valley Road  
Mahwah, New Jersey 07430-1630

CONSTRUCTION MANAGERS:  
Cambridge Construction Management  
335 East Main Street  
Somerville, NJ 08876  
908-253-9500

ARCHITECT:  
Mitchell/Giurgola Architects, LLP  
600 Ninth Avenue, Suite 711  
New York, New York 10036  
212 663 4000

MEP ENGINEER:  
Joseph R. Loring & Associates, Inc.  
619 Pennsylvania Plaza  
New York, NY 10001  
212 563 7400


STRUCTURAL ENGINEER:  
Yisrael A Seiniuk PC  
228 East 45th Street 2nd Floor  
New York, NY 10017  
212 687 2233

LANDSCAPE ARCHITECT:  
Dirtworks, PC  
200 Park Avenue South  
New York, NY 10003  
212 529 2263

SITE CIVIL ENGINEER:  
Langan Engineering  
619 River Drive Center 1  
Elmwood Park, NJ 07407-1338  
201 794 6900

AV CONSULTANT:  
Ceramni & Associates  
404 Fifth Avenue  
New York, NY 10018  
212 370 1776

Key Plan:

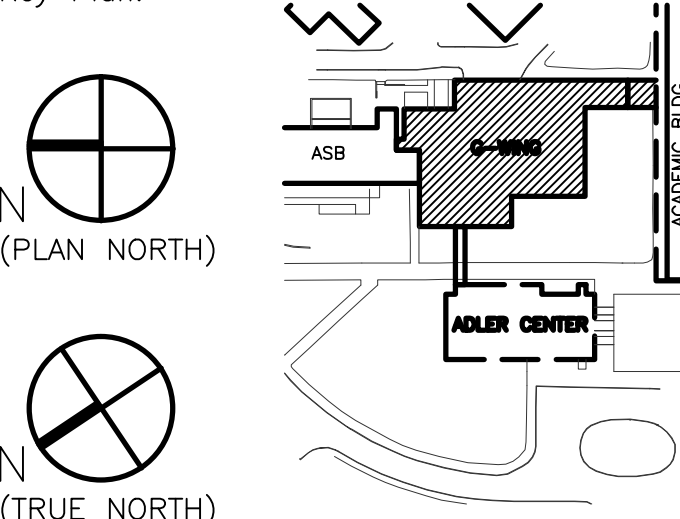

N (PLAN NORTH)

N (TRUE NORTH)

6/8/12	DCA FILING
7/19/12	ISSUED FOR BID
10/4/12	BID ADDENDUM #4
11/21/12	BID ADDENDUM #5
1/15/13	ISSUED FOR CONSTRUCTION
1/6/15	BULLETIN #28
8/12/16	AS-BUILT CONSTRUCTION DOCUMENTS

NR	DATE	COMMENTS
ISSUE/REVISION		
ALL DIMENSIONS AND EXISTING CONDITIONS SHALL BE CHECKED AND VERIFIED BY THE CONTRACTOR BEFORE PROCEEDING WITH THE WORK.		

Project:  
G-WING RENOVATION &  
ADLER CENTER

Submission:  
CONSTRUCTION DOCUMENTS

Drawing Title:  
ELECTRICAL  
LIGHTING FIXTURE SCHEDULE  
G-WING

PROJECT NR: 102700	DATE: 6/8/12
RCNJ PROJ. NR: 08-240C	SCALE: NONE

E5.00

PA-83207-000 Ramapo College-G Wing Existing Conditions and Programming Effort Ramsey N\1-CAD\ELEC-G-Wing Drawings\8327 - E-500.dwg 02/21/2017 12:10 Last printed by: viktorin