

- GENERAL NOTES:**
1. PROVIDE ALL PIPING APPURTENANCES, VALVES, ETC. AS INDICATED ON PLANS AND DETAIL SHEETS.
  2. ALL PIPING SPECIALTIES SHALL BE LINE SIZE. ALL CONTROL VALVES SHALL SIZED AS SPECIFIED.
  3. REFER TO PLANS FOR ADDITIONAL PIPE SIZES.
  4. ALL PIPING SHALL BE NEW UNLESS SPECIFICALLY INDICATED OTHERWISE. COORDINATE INSTALLATION SEQUENCE WITH CONSTRUCTION MANAGER.



OWNER:  
Ramapo College of New Jersey  
505 Ramapo Valley Road  
Mahwah, New Jersey 07430-1630

CONSTRUCTION MANAGERS:  
Cambridge Construction Management  
335 East Main Street  
Somerville, NJ 08876  
908-253-9500

ARCHITECT:  
Mitchell/Giurgola Architects, LLP  
630 Ninth Avenue, Suite 711  
New York, New York 10036  
212 663 4000

M/E ENGINEER:  
Joseph R. Loring & Associates, Inc.  
619 River Drive Center 1  
New York, NY 10001  
212 563 7400


STRUCTURAL ENGINEER:  
Yarael A. Seiniuk PC  
228 East 45th Street 2nd Floor  
New York, NY 10017  
212 687 2233

LANDSCAPE ARCHITECT:  
Dirtworks, PC  
200 Park Avenue South  
New York, NY 10003  
212 529 2263

SITE CIVIL ENGINEER:  
Langan Engineering  
619 River Drive Center 1  
Elmwood Park, NJ 07407-1338  
201 794 6900

AV CONSULTANT:  
Cerami & Associates  
404 Fifth Avenue  
New York, NY 10018  
212 370 1776

Key Plan:

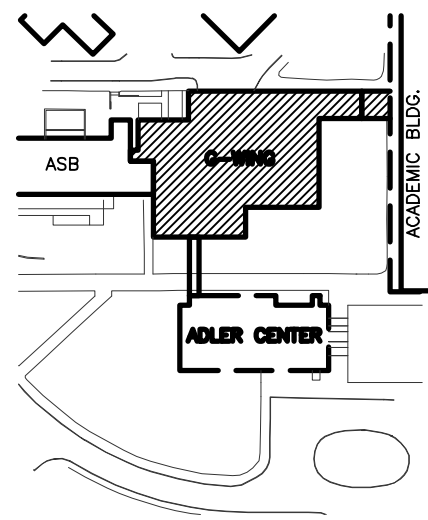

6/8/12	DCA FILING
7/19/12	ISSUED FOR BID
1/15/13	ISSUED FOR CONSTRUCTION
9/04/13	BULLETIN #9
8/12/16	AS-BUILT CONSTRUCTION DOCUMENTS

NR	DATE	COMMENTS
1	6/8/12	DCA FILING
2	7/19/12	ISSUED FOR BID
3	1/15/13	ISSUED FOR CONSTRUCTION
4	9/04/13	BULLETIN #9
5	8/12/16	AS-BUILT CONSTRUCTION DOCUMENTS

ALL DIMENSIONS AND EXISTING CONDITIONS SHALL BE CHECKED AND VERIFIED BY THE CONTRACTOR BEFORE PROCEEDING WITH THE WORK.

Project:  
G-WING RENOVATION &  
ADLER CENTER

Submission:  
**CONSTRUCTION DOCUMENTS**

Drawing Title:  
**MECHANICAL  
PIPING RISER DIAGRAM  
G-WING**

PROJECT NR: 102700 DATE: 6/8/12  
RCNJ PROJ. NR: 08-240C SCALE: NONE

**H4.02G**