


01 PENTHOUSE MER PART PLAN - SOUTH  
SCALE: 1/4" = 1'-0"

- SUPPORT GENERATOR EXHAUST FROM SUPPORT BRACKETS PROVIDED ON SIDE OF GENERATOR ENCLOSURE BY GENERATOR MANUFACTURER. COORDINATE DETAILS. PROVIDE HARDWARE, SUPPORT ACCESSORIES, EXHAUST VENT FITTINGS AND SECURE. SEE GENERATOR MANUFACTURER'S SHOP DRAWINGS, ARCHITECTURAL DRAWINGS AND COORDINATE. CONTRACTOR TO SUBMIT DETAILS FOR REVIEW AND APPROVAL BY STRUCTURAL ENGINEER. SEE STRUCTURAL DRAWINGS FOR WIND LOAD COMPLIANCE REQUIREMENTS.
- CONTRACTOR TO COORDINATE ELEVATIONS OF DUCTWORK WITH STRUCTURAL STEEL DUNNAGE FOR GENERATOR.

- GENERAL NOTES:
- PROVIDE INSULATED BLANK-OFF PANELS FOR ALL UNUSED LOUVER. BLANK-OFF PANEL TO HAVE 2" THICK INSULATION. BLANK-OFF TO BE DOUBLE WALL CONSTRUCTION. CAULK/SEAL AIRTIGHT.
  - PROVIDE MINIMUM 1" ACOUSTICAL LINING FOR 30'-0" DOWNSTREAM OF AHU-4 & 5. PROVIDE MINIMUM 1" ACOUSTICAL LINING FOR 30'-0" UPSTREAM OF RF-1 & 2.
  - REFER TO DRAWING H5.056 FOR PIPING.
  - REMOVE ALL TEMPORARY WORK AFTER PERMANENT MEASURES HAVE BEEN PUT INTO SERVICE.
  - ALL EXHAUST DUCTWORK LOCATED IN PENTHOUSE AND ON ROOF TO BE STAINLESS STEEL WELDED CONSTRUCTION.
  - PROTECT ALL EQUIPMENT FROM RAIN, WATER, ETC. DURING CONSTRUCTION/EXPANSION OF MECHANICAL PENTHOUSE.
  - PROVIDE 1" TRAPPED DRAIN LINE FROM EACH OUTSIDE AIR INTAKE PLENUM. PIPE EACH DRAIN TO NEAREST FLOOR DRAIN. INSULATE ALL DRAIN LINES.



- OWNER:  
Ramapo College of New Jersey  
505 Ramapo Valley Road  
Mahwah, New Jersey 07430-1630
- CONSTRUCTION MANAGERS:  
Cambridge Construction Management  
335 East Main Street  
Somerville, NJ 08876  
908-253-9500
- ARCHITECT:  
Mitchell/Giurgola Architects, LLP  
630 Ninth Avenue, Suite 711  
New York, New York 10036  
212 529 2263
- MEP ENGINEER:  
Joseph R. Loring & Associates, Inc.  
619 River Drive Center 1  
New York, NY 10001  
212 563 7400
- STRUCTURAL ENGINEER:  
Yarael A. Seiniuk PC  
228 East 45th Street 2nd Floor  
New York, NY 10017  
212 687 2233
- LANDSCAPE ARCHITECT:  
Dirtworks, PC  
200 Park Avenue South  
New York, New York 10003  
212 529 2263
- SITE CIVIL ENGINEER:  
Langan Engineering  
619 River Drive Center 1  
New York, NY 10001  
201 794 6900
- AV CONSULTANT:  
Cerami & Associates  
404 Fifth Avenue  
New York, NY 10018  
212 370 1776

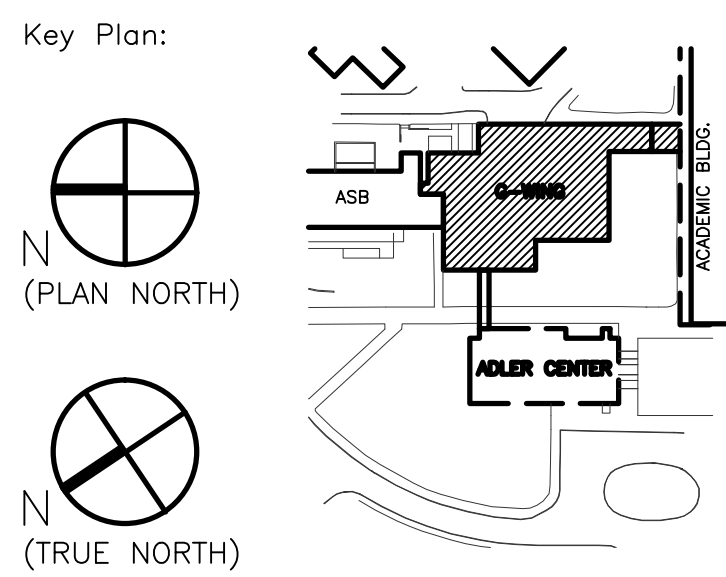

DATE	ISSUE/REVISION	COMMENTS
6/8/12	DCA FILING	
7/19/12	ISSUED FOR BID	
12/10/12	BID ADDENDUM #6	
1/15/13	ISSUED FOR CONSTRUCTION	
12/19/13	BULLETIN #16	
8/12/16	AS-BUILT CONSTRUCTION DOCUMENTS	

Project:  
G-WING RENOVATION &  
ADLER CENTER

Submission:  
CONSTRUCTION DOCUMENTS

Drawing Title:  
MECHANICAL  
PENTHOUSE MER  
PART PLAN SHEET No.2  
G-WING

PROJECT NO: 102700 DATE: 6/8/12  
CONJ PROJ. NO: 08-240C SCALE: 1/4"=1'-0"

H5.03G