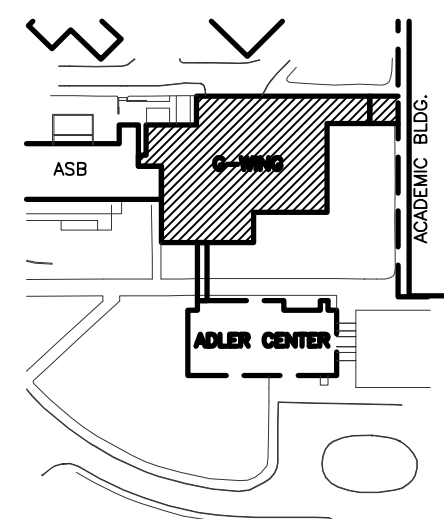


- OWNER:
Ramapo College of New Jersey
505 Ramapo Valley Road
Mahwah, New Jersey 07430-1630
- CONSTRUCTION MANAGERS:
Cambridge Construction Management
335 East Main Street
Somerville, NJ 08876
908-253-9500

- ARCHITECT:
Mitchell/Giurgola Architects, LLP
630 Ninth Avenue, Suite 711
New York, New York 10036
212 663 4000
- MEP ENGINEER:
Joseph R. Loring & Associates, Inc.
219 Pennsylvania Plaza
New York, NY 10001
212 563 7400
- STRUCTURAL ENGINEER:
Yisrael A. Seiniuk PC
228 East 45th Street 2nd Floor
New York, NY 10017
212 687 2233

- LANDSCAPE ARCHITECT:
Dirtworks, PC
200 Park Avenue South
New York, NY 10003
212 529 2263
- SITE CIVIL ENGINEER:
Langan Engineering
619 River Drive Center 1
Elmwood Park, NJ 07407-1338
201 794 6900
- AV CONSULTANT:
Cerami & Associates
404 Fifth Avenue
New York, NY 10018
212 370 1776

Key Plan:

N
(PLAN NORTH)

N
(TRUE NORTH)

6/8/12	DCA FILING
7/19/12	ISSUED FOR BID
9/28/12	BID ADDENDUM #3
12/10/12	BID ADDENDUM #6
12/20/12	DCA RESUBMISSION
1/15/13	ISSUED FOR CONSTRUCTION
1/16/13	DCA RESUBMISSION/BULLETIN #1
6/12/16	AS-BUILT CONSTRUCTION DOCUMENTS

NR	DATE	COMMENTS
ISSUE/REVISION		
ALL DIMENSIONS AND EXISTING CONDITIONS SHALL BE CHECKED AND VERIFIED BY THE CONTRACTOR BEFORE PROCEEDING WITH THE WORK.		

Project:
G-WING RENOVATION & ADLER CENTER

Submission:
CONSTRUCTION DOCUMENTS

Drawing Title:
**PLUMBING
SANITARY AND DOMESTIC
WATER RISER DIAGRAMS
G-WING**

PROJECT NR: 102700	DATE: 6/8/12
RCNJ PROJ. NR: 08-240C	SCALE: NONE

P4.01G