

**01** PENTHOUSE MER PART PLAN - NORTH  
SCALE: 1/4"=1'-0"

- GENERAL NOTES:
1. PROVIDE INSULATED BLANK-OFF PANELS FOR ALL UNUSED LOUVER. BLANK-OFF PANEL TO HAVE 2" THICK INSULATION. BLANK-OFF TO BE DOUBLE WALL CONSTRUCTION. CAULK/SEAL AIRTIGHT.
  2. PROVIDE MINIMUM 1" ACOUSTICAL LINING FOR 30"-0" DOWNSTREAM OF AHU-4 & 5. PROVIDE MINIMUM 1" ACOUSTICAL LINING FOR 30"-0" UPSTREAM OF RF-1 & 2.
  3. REFER TO DRAWING H5.05G FOR PIPING.
  4. REMOVE ALL TEMPORARY WORK AFTER PERMANENT MEASURES HAVE BEEN PUT INTO SERVICE.
  5. ALL EXHAUST DUCTWORK LOCATED IN PENTHOUSE AND ON ROOF TO BE STAINLESS STEEL WELDED CONSTRUCTION.
  6. PROTECT ALL EQUIPMENT FROM RAIN, WATER, ETC. DURING CONSTRUCTION/EXPANSION OF MECHANICAL PENTHOUSE.
  7. PROVIDE 1" TRAPPED DRAIN LINE FROM EACH OUTSIDE AIR INTAKE PLENUM. PIPE EACH DRAIN TO NEAREST FLOOR DRAIN. INSULATE ALL DRAIN LINES.



OWNER:  
Ramapo College of New Jersey  
505 Ramapo Valley Road  
Mahwah, New Jersey 07430-1630

CONSTRUCTION MANAGERS:  
Cambridge Construction Management  
335 East Main Street  
Somerville, NJ 08876  
908-253-9500

ARCHITECT:  
Mitchell/Giurgola Architects, LLP  
600 Ninth Avenue, Suite 711  
New York, New York 10036  
212 663 4000


MEP ENGINEER:  
Joseph R. Loring & Associates, Inc.  
619 Pennsylvania Plaza  
New York, NY 10001  
212 563 7400

STRUCTURAL ENGINEER:  
Yarael A. Seiniuk PC  
228 East 45th Street 2nd Floor  
New York, NY 10017  
212 687 2233

LANDSCAPE ARCHITECT:  
Dirtworks, PC  
200 Park Avenue South  
New York, NY 10003  
212 529 2263

SITE CIVIL ENGINEER:  
Langan Engineering  
619 River Drive Center 1  
Elmwood Park, NJ 07407-1338  
201 794 6900

AV CONSULTANT:  
Cerami & Associates  
404 Fifth Avenue  
New York, NY 10018  
212 370 1776

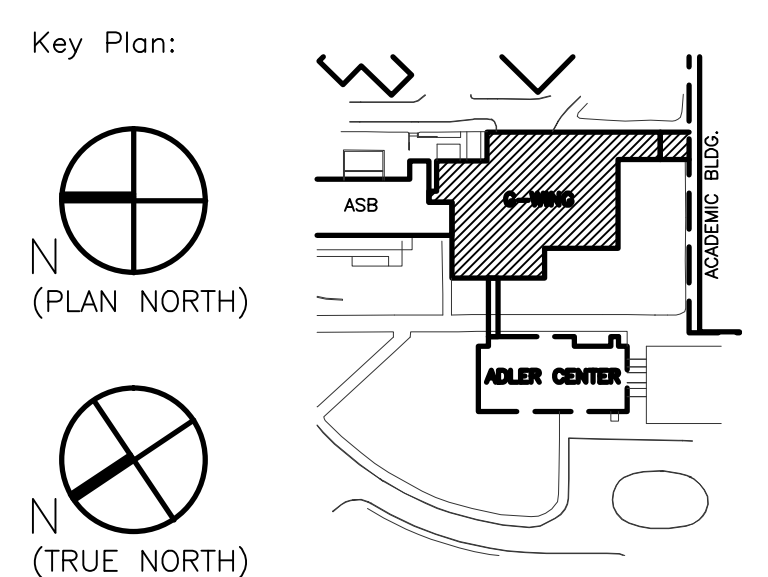

6/8/12	DCA FILING
7/19/12	ISSUED FOR BID
1/15/13	ISSUED FOR CONSTRUCTION
9/04/13	BULLETIN #9
1/06/16	BULLETIN #36
8/12/16	AS-BUILT CONSTRUCTION DOCUMENTS

NR	DATE	COMMENTS
1		ISSUE/REVISION

ALL DIMENSIONS AND EXISTING CONDITIONS SHALL BE CHECKED AND VERIFIED BY THE CONTRACTOR BEFORE PROCEEDING WITH THE WORK.

Project:  
**G-WING RENOVATION & ADLER CENTER**

Submission:  
**CONSTRUCTION DOCUMENTS**

Drawing Title:  
**MECHANICAL PENTHOUSE MER PART PLAN SHEET No.1 G-WING**

PROJECT NR: 102700	DATE: 6/8/12
CONJ PROJ. NR: 08-240C	SCALE: 1/4"=1'-0"

**H5.02G**