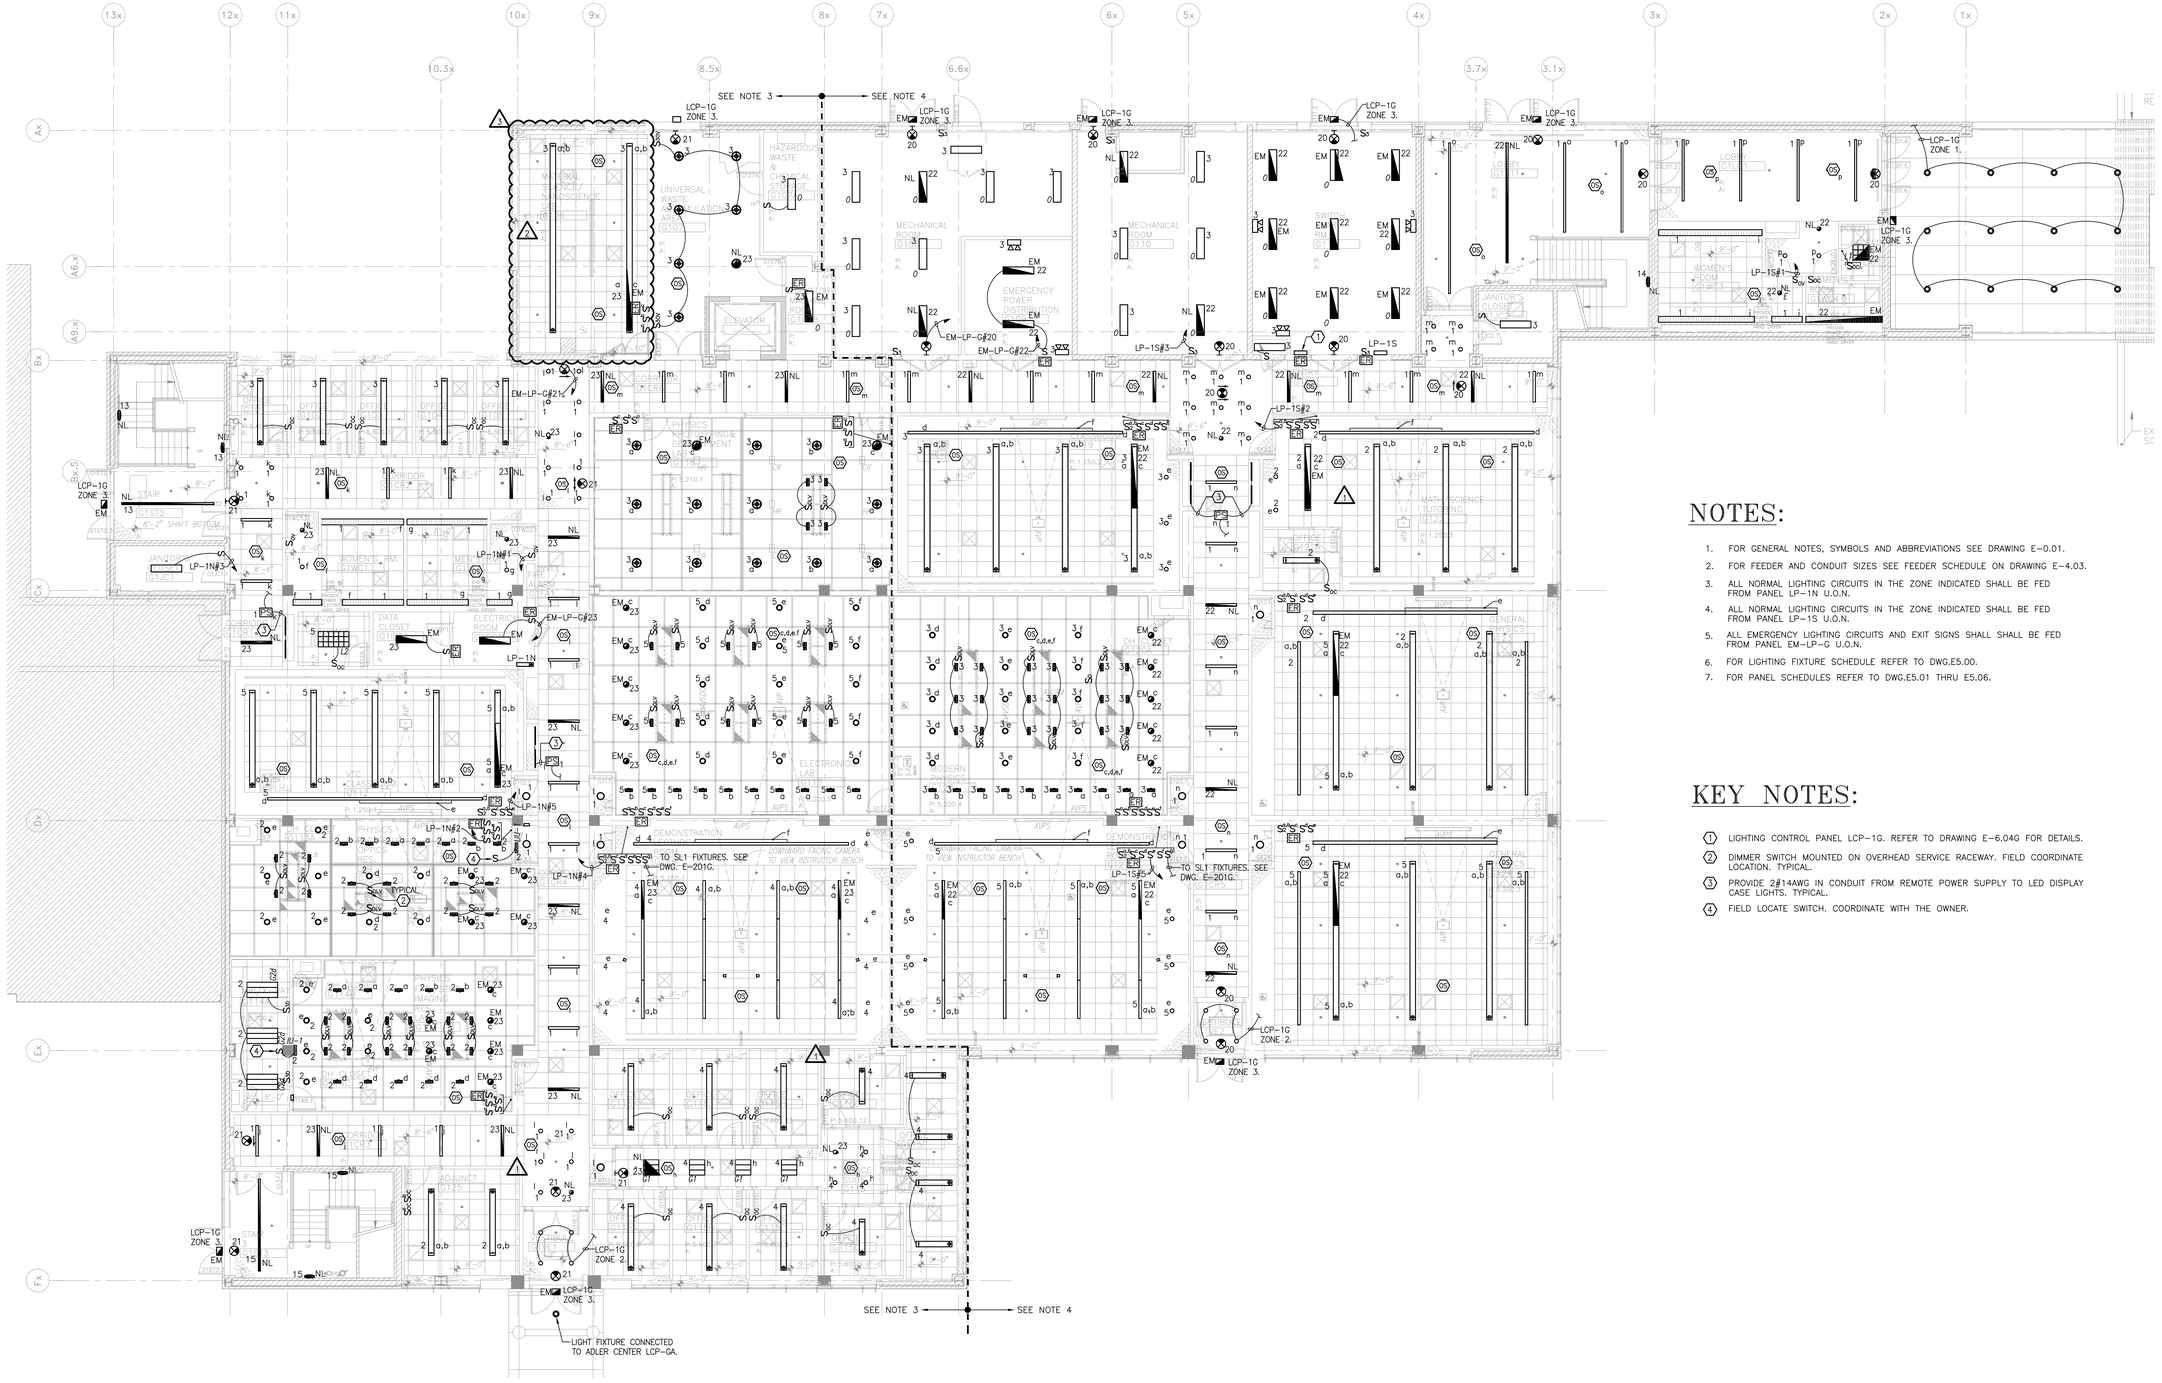

NOTES:

1. FOR GENERAL NOTES, SYMBOLS AND ABBREVIATIONS SEE DRAWING E-0.01.
2. FOR FEEDER AND CONDUIT SIZES SEE FEEDER SCHEDULE ON DRAWING E-4.03.
3. ALL NORMAL LIGHTING CIRCUITS IN THE ZONE INDICATED SHALL BE FED FROM PANEL LP-1N U.O.N.
4. ALL NORMAL LIGHTING CIRCUITS IN THE ZONE INDICATED SHALL BE FED FROM PANEL LP-1S U.O.N.
5. ALL EMERGENCY LIGHTING CIRCUITS AND EXIT SIGNS SHALL SHALL BE FED FROM PANEL EM-LP-G U.O.N.
6. FOR LIGHTING FIXTURE SCHEDULE REFER TO DWG.E5.00.
7. FOR PANEL SCHEDULES REFER TO DWG.E5.01 THRU E5.06.

KEY NOTES:

1. LIGHTING CONTROL PANEL LCP-1G. REFER TO DRAWING E-6.04G FOR DETAILS.
2. DIMMER SWITCH MOUNTED ON OVERHEAD SERVICE RACEWAY. FIELD COORDINATE LOCATION. TYPICAL.
3. PROVIDE 2#14AWG IN CONDUIT FROM REMOTE POWER SUPPLY TO LED DISPLAY CASE LIGHTS. TYPICAL.
4. FIELD LOCATE SWITCH. COORDINATE WITH THE OWNER.

GRAPHIC SCALE
0 4 8 16 FEET
1/8"=1'-0"

RAMAPO COLLEGE OF NEW JERSEY

- OWNER:
  Ramapo College of New Jersey
  505 Ramapo Valley Road
  Mahwah, New Jersey 07430-1630
- CONSTRUCTION MANAGERS:
  Cambridge Construction Management
  335 East Main Street
  Somerville, NJ 08876
  908-253-9500
- ARCHITECT:
  Mitchell/Giurgola Architects, LLP
  630 Ninth Avenue, Suite 711
  New York, New York 10036
  212 663 4000
- MEP ENGINEER:
  Joseph R. Loring & Associates, Inc.
  21 Pennsylvania Plaza
  New York, NY 10001
  212 563 7400
- STRUCTURAL ENGINEER:
  Ysrael A Seinuk PC
  228 East 45th Street 2nd Floor
  New York, NY 10017
  212 687 2233
- LANDSCAPE ARCHITECT:
  Dirtworks, PC
  200 Park Avenue South
  New York, NY 10003
  212 529 2263
- SITE CIVIL ENGINEER:
  Langan Engineering
  619 River Drive Center 1
  Elmwood Park, NJ 07407-1338
  201 794 6900
- AV CONSULTANT
  Cerami & Associates
  404 Fifth Avenue
  New York, NY 10018
  212 370 1776

Key Plan:

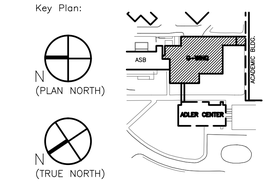

	6/8/12	DCA FILING
	7/19/12	ISSUED FOR BID
	1/15/13	ISSUED FOR CONSTRUCTION
1	12/12/14	BULLETIN #27
2	12/07/15	BULLETIN #35
	8/12/16	AS-BUILT CONSTRUCTION DOCUMENTS
3	2/17/17	BULLETIN #35 REVISED
Nº	DATE	COMMENTS
ISSUE/REVISION		

ALL DIMENSIONS AND EXISTING CONDITIONS SHALL BE CHECKED AND VERIFIED BY THE CONTRACTOR BEFORE PROCEEDING WITH THE WORK.

Project:
G-WING RENOVATION & ADLER CENTER

Submission:
CONSTRUCTION DOCUMENTS

Drawing Title:
ELECTRICAL
1ST FLOOR LIGHTING PLAN
G-WING

PROJECT Nº:	102700	DATE:	6/8/12
RCNJ PROJ. Nº:	08-240C	SCALE:	1/8"=1'-0"

E3.01G

P:\8227-000 Ramapo College-G Wing Existing Conditions and Programming Effort Ramsey NJ\I-CAD\ELEC\G-Wing Drawings\8227 - E-3010.dwg 02/22/2017 09:32 Last printed by: viktorin