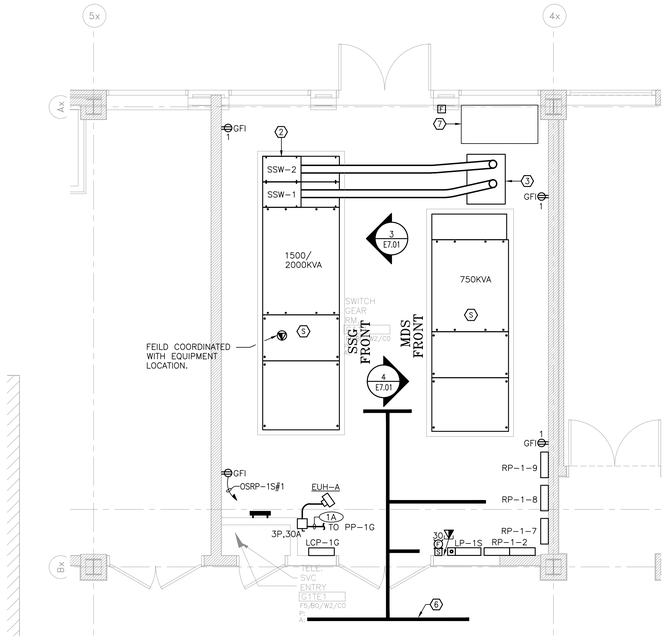

01 G-WING ELECTRICAL SERVICE ROOM PART PLAN
SCALE: 1/4" = 1'-0"

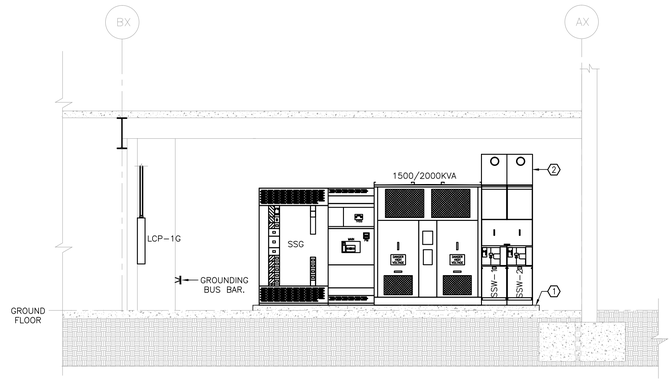

03 SSG ELEVATION
SCALE: 1/4" = 1'-0"

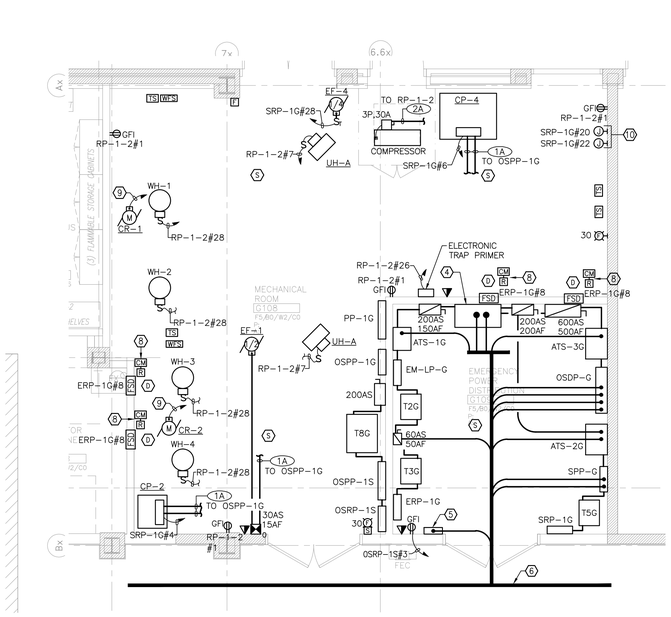

02 G-WING 1ST FLOOR PART PLAN
SCALE: 1/4" = 1'-0"

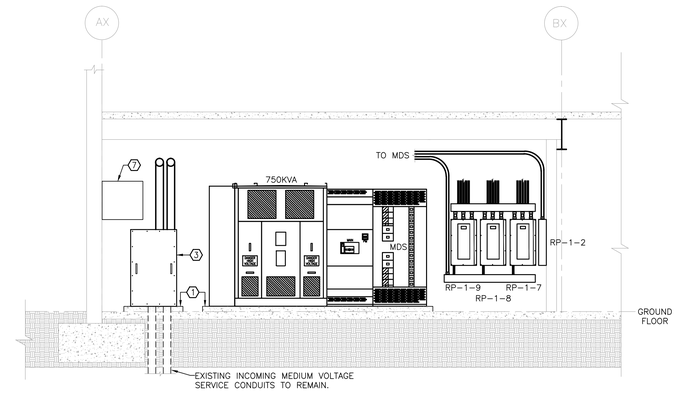

04 MDS ELEVATION
SCALE: 1/4" = 1'-0"

NOTES:

1. FOR GENERAL NOTES, SYMBOLS AND ABBREVIATIONS SEE DRAWING E-0.01.

KEY NOTES:

1. 4" HIGH CONCRETE HOUSEKEEPING PAD. COORDINATE SIZE WITH THE DIMENSIONS OF THE EQUIPMENT.
2. 40"x30"x24" MIN. NEMA 1 CROWN BOX WITH REMOVABLE SIDE PANELS. MATCH THE COLOR OF THE BOX WITH THE FINISH OF THE EQUIPMENT.
3. 36"x30"x60" MIN. NEMA 1, 10 GAUGE STEEL PULL BOX WITH REMOVABLE SIDE PANELS. EACH REMOVABLE PANEL SHALL BE EQUIPPED WITH HANDLES (TWO PER PANEL). MATCH THE COLOR OF THE BOX WITH THE FINISH OF THE EQUIPMENT.
4. 36"x36"x18" MIN. NEMA 1 BOX WITH 800A BUS DETAIL. MATCH THE COLOR OF THE BOX WITH THE FINISH OF THE EQUIPMENT.
5. REMOTE GENERATOR ANNUNCIATOR PANEL. COORDINATE FINAL LOCATION WITH THE OWNER.
6. PROPOSED ROUTE OF CONDUITS. COORDINATE ROUTE WITH WORK OF OTHER TRADES.
7. HVAC AIR PLENUM ABOVE. COORDINATE WORK.
8. FOR FIRE SMOKE DAMPER (FSD) OPERATION. TYPICAL.
9. TO RP-1-2 #27 VIA DEDICATED AQUASTAT. PROVIDE ALL REQUIRED WIRING.
10. POWER FOR HVAC CONTROLS, VAV'S, VALVES, ECT.

RAMAPO COLLEGE OF NEW JERSEY

- OWNER:
  Ramapo College of New Jersey
  505 Ramapo Valley Road
  Mahwah, New Jersey 07430-1630
- CONSTRUCTION MANAGERS:
  Cambridge Construction Management
  335 East Main Street
  Somerville, NJ 08876
  908-253-9500
- ARCHITECT:
  Mitchell/Giurgola Architects, LLP
  630 Ninth Avenue, Suite 711
  New York, New York 10036
  212 663 4000
- MEP ENGINEER:
  Joseph R. Loring & Associates, Inc.
  21 Pennsylvania Plaza
  New York, NY 10001
  212 563 7400
- STRUCTURAL ENGINEER:
  Ysrael A Seinuk PC
  228 East 45th Street 2nd Floor
  New York, NY 10017
  212 687 2233
- LANDSCAPE ARCHITECT:
  Dirtworks, PC
  200 Park Avenue South
  New York, NY 10003
  212 529 2263
- SITE CIVIL ENGINEER:
  Langan Engineering
  619 River Drive Center 1
  Elmwood Park, NJ 07407-1338
  201 794 6900
- AV CONSULTANT
  Cerami & Associates
  404 Fifth Avenue
  New York, NY 10018
  212 370 1776

Key Plan:

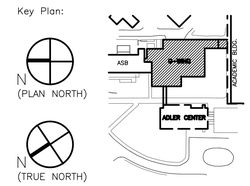

	6/8/12	DCA FILING
	7/19/12	ISSUED FOR BID
	1/15/13	ISSUED FOR CONSTRUCTION
	8/12/16	AS-BUILT CONSTRUCTION DOCUMENTS
Nº	DATE	COMMENTS
ISSUE/REVISION		

ALL DIMENSIONS AND EXISTING CONDITIONS SHALL BE CHECKED AND VERIFIED BY THE CONTRACTOR BEFORE PROCEEDING WITH THE WORK.

Project:
G-WING RENOVATION &
ADLER CENTER

Submission:
CONSTRUCTION DOCUMENTS

Drawing Title:
ELECTRICAL
ELECTRICAL PART PLANS
G-WING

PROJECT Nº:	102700	DATE:	6/8/12
RCNJ PROJ. Nº:	08-240C	SCALE:	AS INDICATED

E7.01G

P:\8227-000 Ramapo College-G Wing Existing Conditions and Programming Effort Ramsey NJ\1-CAD\ELEC\G-Wing Drawings\8227 - E-7010.dwg 02/22/2017 08:52 Last printed by: viktorin